



T.6S. R.4W., W.M

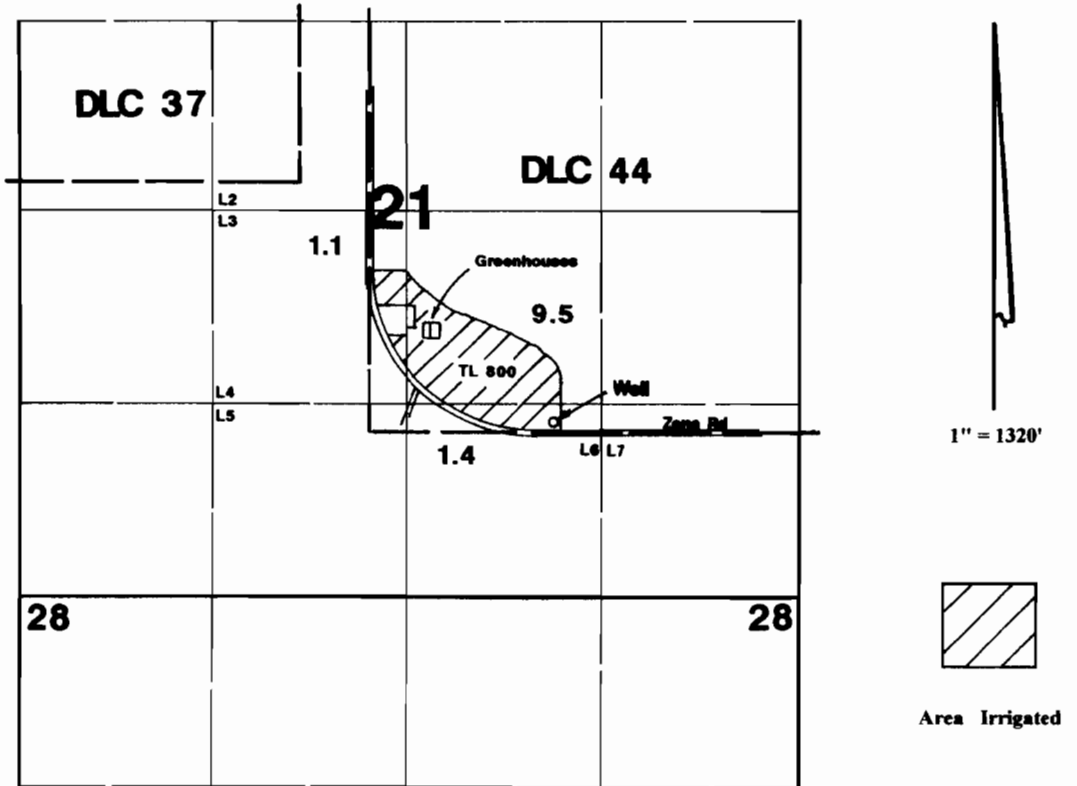

Well is located 80'N & 1250'E from SW corner of DLC 44.

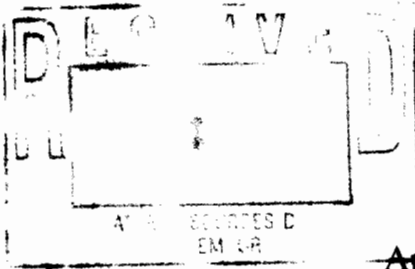

Final Proof Survey

Application #: G-12765

Permit #: G-11659

In Name Of

Alice and Bernard Tranel

Surveyed on August 13, 2001 by JM Schuette

This Map Was Prepared For The Purpose Of Identifying The Location Of A Water Right Only And Is Not Intended To Provide Legal Dimensions Or Location Of Property Ownership Lines.

