
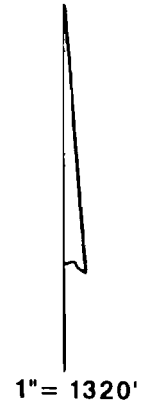


RECEIVED

NOV 14 1996

WATER RESOURCES DEPT
SALEM, OREGON

T.7S., R.2W., W.M.

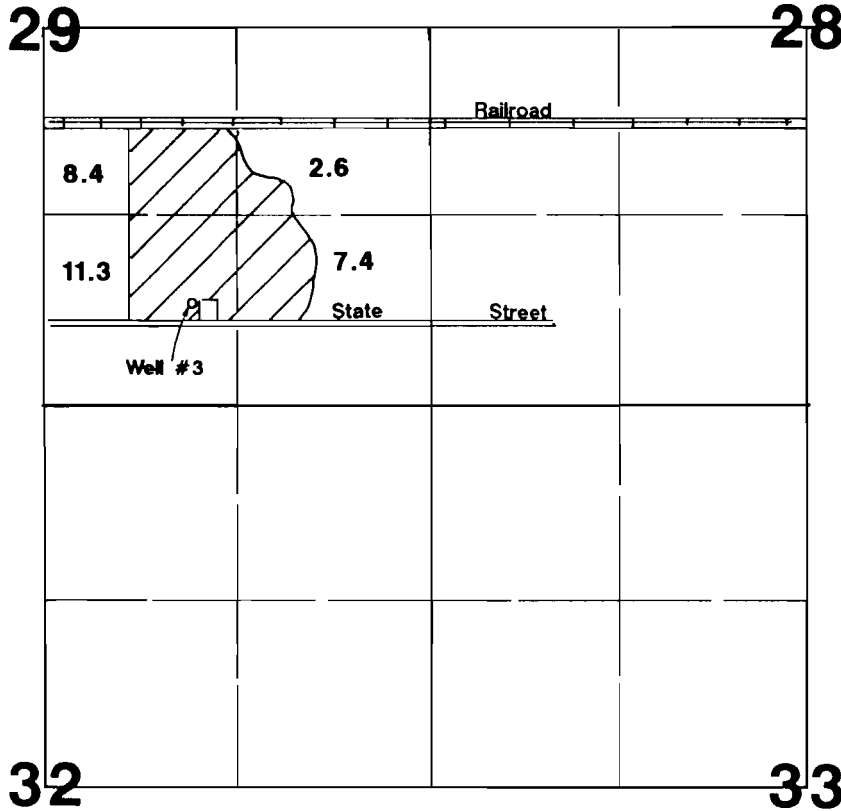

Well #3 located 720'N & 1650'W from SE corner Section 29.

Final Proof Survey

Application #: G-12222 Permit #: G-11666

In Name Of

Myron Kuenzi

Surveyed on November 9, 1996 by JM Schuette

THIS MAP WAS PREPARED FOR THE PURPOSE OF IDENTIFYING THE LOCATION OF A WATER RIGHT ONLY AND IS NOT INTENDED TO PROVIDE LEGAL DIMENSIONS OR LOCATION OF PROPERTY OWNERSHIP LINES.

