
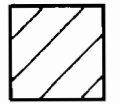


T.6S. & 7S., R.2W., W.M.

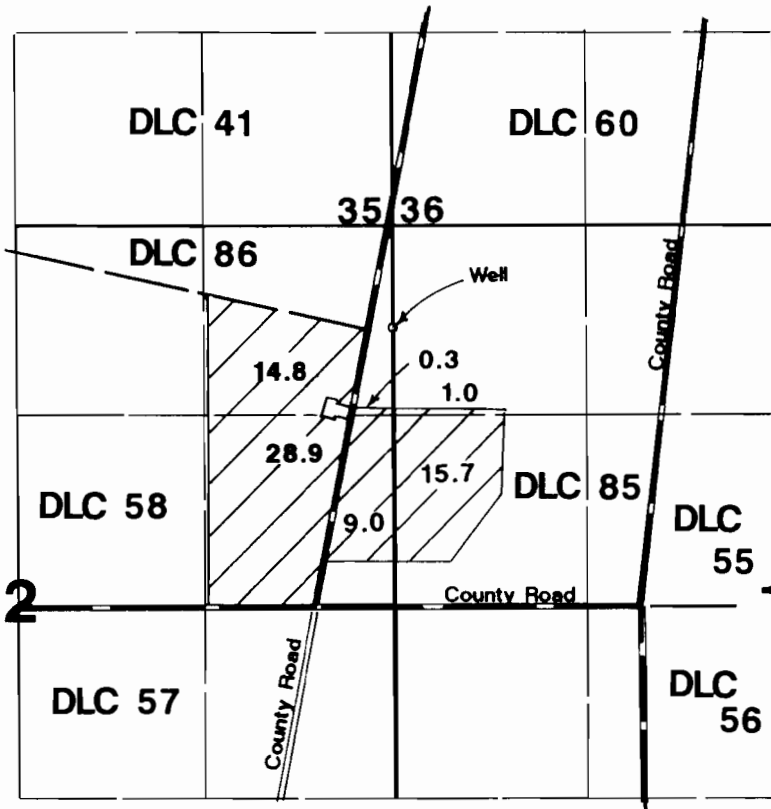

Area Irrigated

Well located 190'E from SE corner DLC 86.

RECEIVED

SEP 17 1996

CLARENCE SIMMONS

Final Proof Survey

Application #: G-12739 Permit #: G-11669

In Name Of

Clarence Simmons

Surveyed on September 6, 1996 by JM Schuette

THIS MAP WAS PREPARED FOR THE PURPOSE OF IDENTIFYING THE LOCATION OF A WATER RIGHT ONLY AND IS NOT INTENDED TO PROVIDE LEGAL DIMENSIONS OR LOCATION OF PROPERTY OWNERSHIP LINES.

