


RECEIVED

SEP 16 1997

WATER RESOURCES DEPT.
SALEM, OREGON

T.6S., R.1W., W.M.

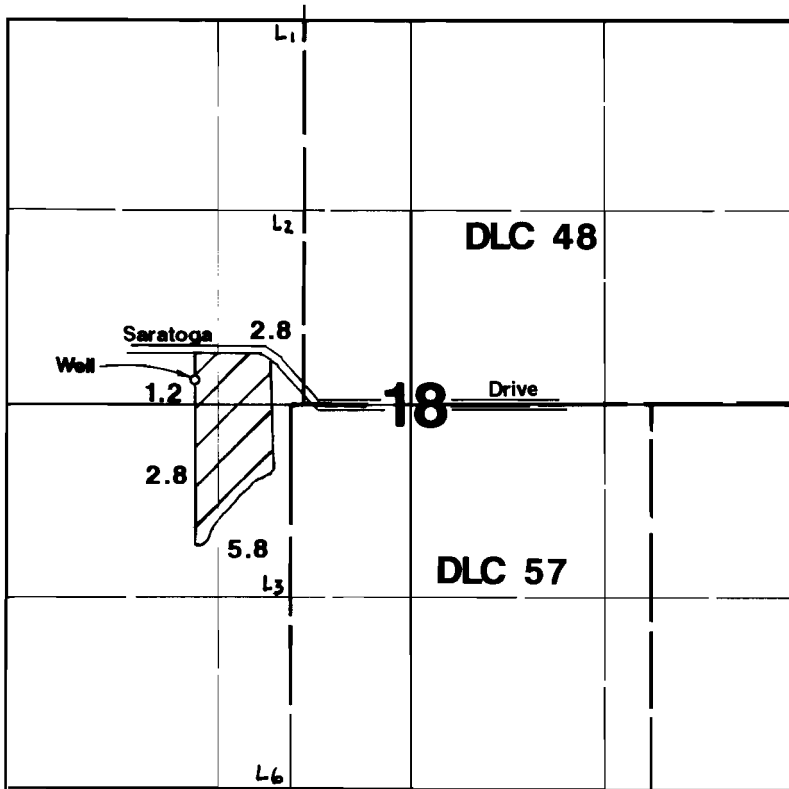

Well located 180'N & 1500'W from center of Section 18.

Final Proof Survey

Application #: G-12819

Permit #: G-11680

In Name Of

Sinn Bros.

Surveyed on September 11, 1997 by JM Schuette

THIS MAP WAS PREPARED FOR THE PURPOSE OF IDENTIFYING THE LOCATION OF A WATER RIGHT ONLY AND IS NOT INTENDED TO PROVIDE LEGAL DIMENSIONS OR LOCATION OF PROPERTY OWNERSHIP LINES.

