


RECEIVED
SEP 28 1998
WATER RESOURCES DEPT.
SALEM, OREGON

SECTIONS 32 AND 33,
TOWNSHIP 1 S. RANGE 13 E. W.M.
WASCO COUNTY, OREGON

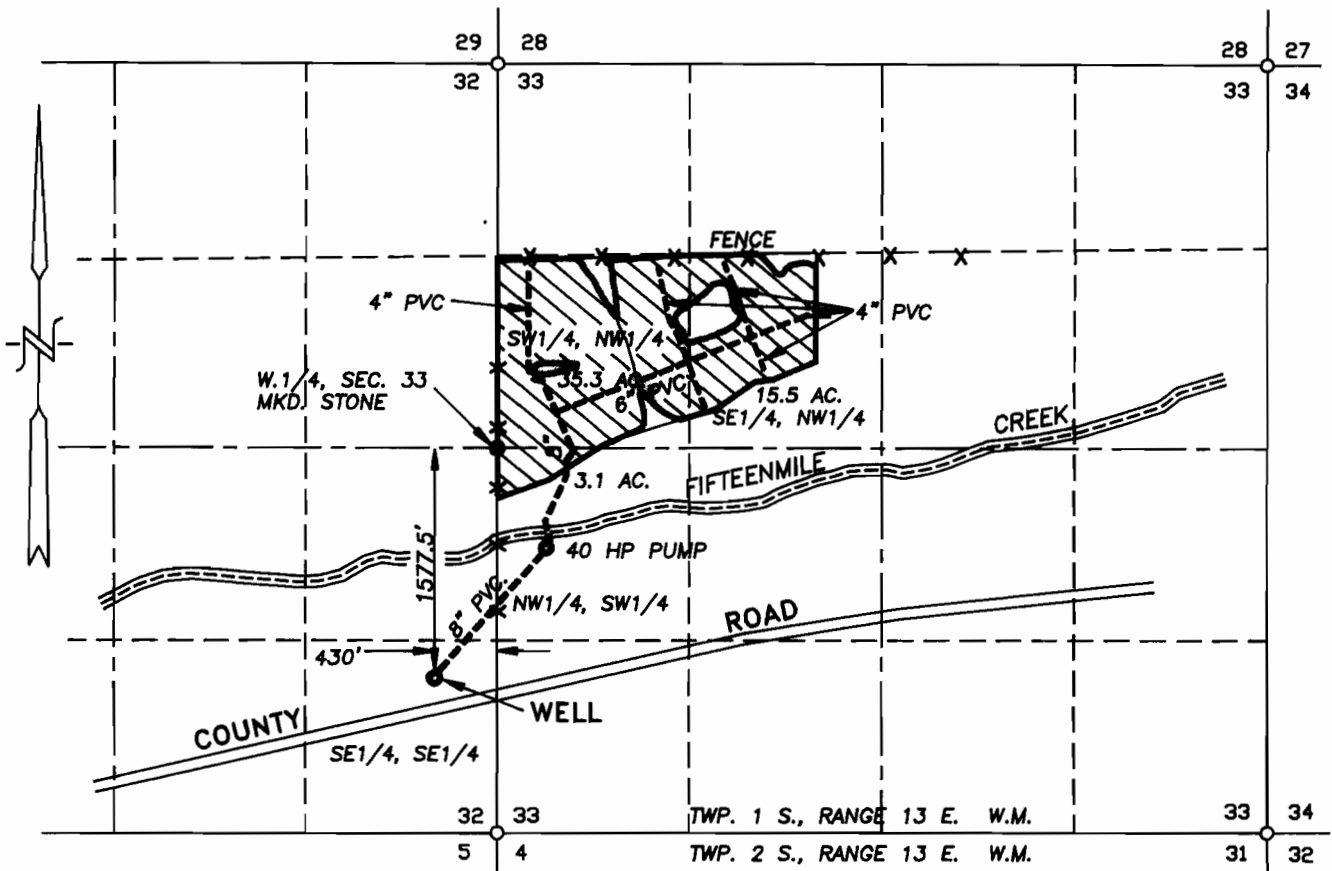

WELL LOCATED 1577.5' S. & 430' W. FROM
THE W.1/4 CORNER, SECTION 33.

WATER RIGHT
FINAL PROOF SURVEY

SCALE: 1" = 1320'

APPLICATION No. G-12273


PERMIT No. G-11691

IN THE NAME OF:

D. PAUL SCHANNO, JR.

DATE: SEPTEMBER 22, 1998

BY: TENNESON ENGINEERING CORP.
409 LINCOLN STREET,
THE DALLES, OREGON. 97058
PH. 541-296-9177
FAX 541-296-6657

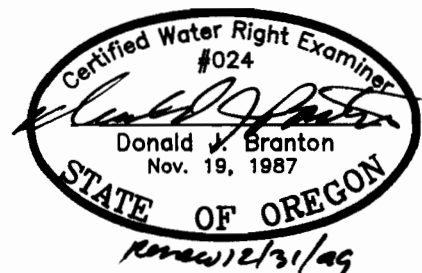

NOTE:

"THIS MAP IDENTIFIES THE LOCATION OF
THE WATER RIGHT ONLY AND IS NOT
INTENDED TO PROVIDE DIMENSIONS OR
LOCATE PROPERTY OWNERSHIP LINES."

W.O. #7326A