


T1N., R2W., W.M.

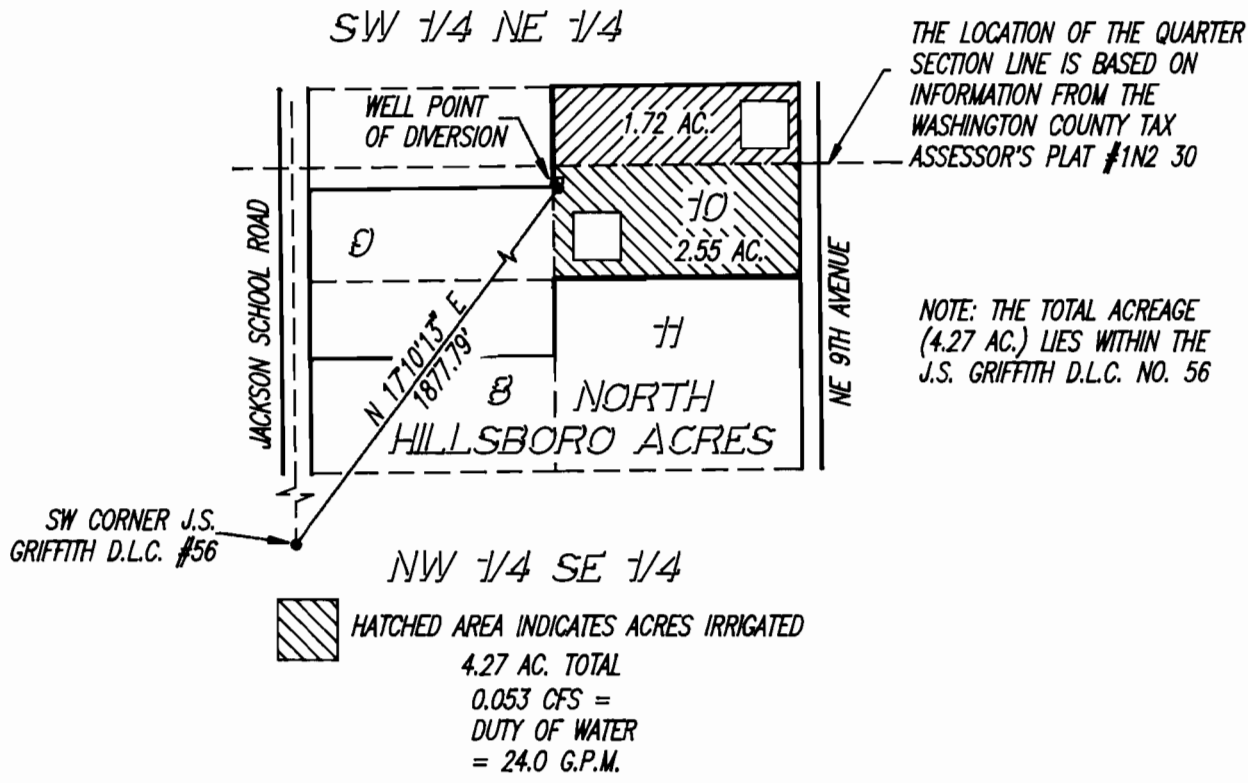

# FINAL PROOF SURVEY


UNDER

Application No. G-12483 Permit No. G-11692

IN NAME OF

THE CHURCH OF JESUS CHRIST OF LATTER DAY SAINTS

Surveyed AUGUST 20, 1997, by A.M. KLEIN

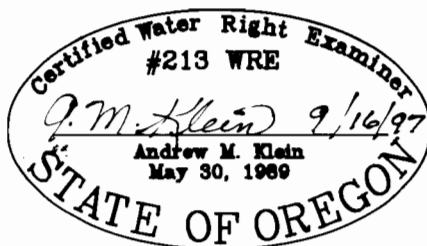

SCALE: 1" = 400'



EXPIRES 06/30/99

THIS MAP IS FOR THE PURPOSE OF IDENTIFYING THE LOCATION OF THE WATER RIGHT ONLY AND IS NOT INTENDED TO PROVIDE LEGAL DIMENSIONS OR THE LOCATION OF PROPERTY OWNERSHIP LINES.