


TOWNSHIP 16 SOUTH, RANGE 4 WEST, W.M.

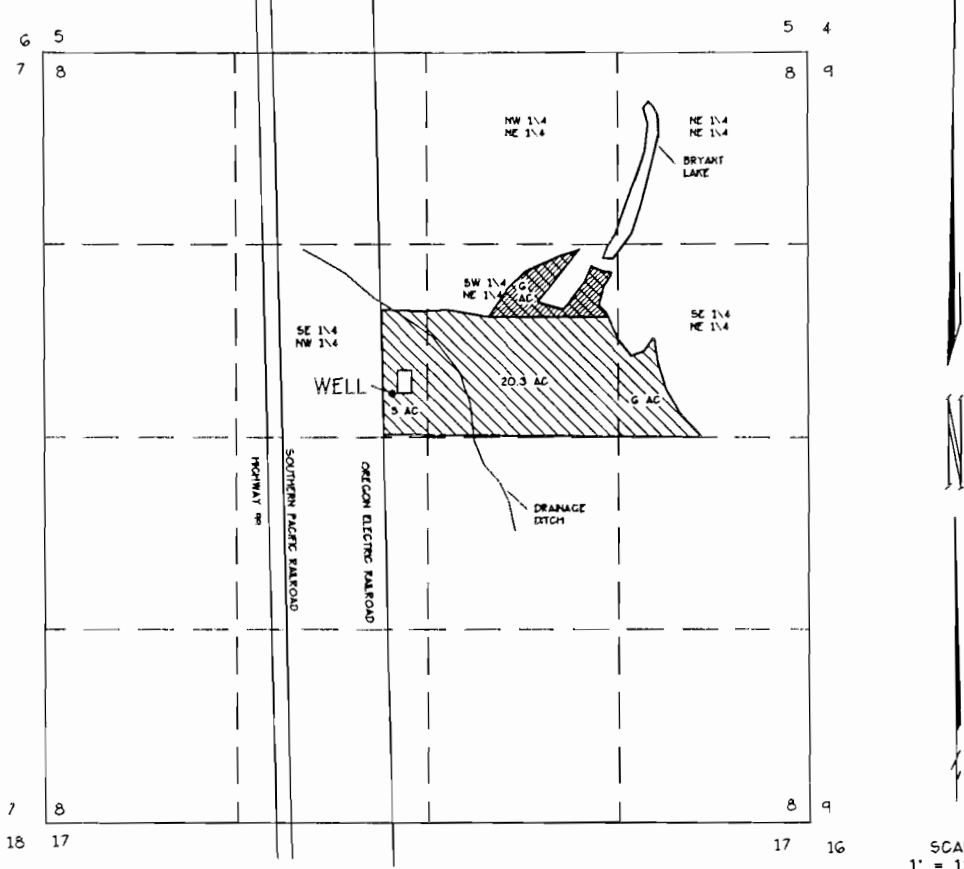

WELL LOCATION:  
 2970 FEET SOUTH +  
 2838 FEET WEST FROM  
 THE NE CORNER SECTION 8.



PRIMARY AREA



SUPPLEMENTAL AREA

THIS MAP WAS PREPARED TO IDENTIFY THE LOCATION OF THE AREA INVOLVED IN THIS WATER RIGHT APPLICATION ONLY. IT IS NOT INTENDED TO PROVIDE DIMENSIONS OR LOCATION OF PROPERTY OWNERSHIP LINES

FINAL PROOF SURVEY

APPLICATION G-12511 PERMIT G-11694  
 FOR  
 STROME-FISHER FARMS, INC.  
 PO BOX 368  
 JUNCTION CITY, OREGON 97448  
 PH (541) 998-8000

BY  
 FORD-NESS-FASSBENDER, INC.  
 PO BOX 22735  
 EUGENE, OREGON 97402  
 PH (541) 344-1852  
 JUNE 3, 1986

