


T. 8S., R. 40E., W.M.

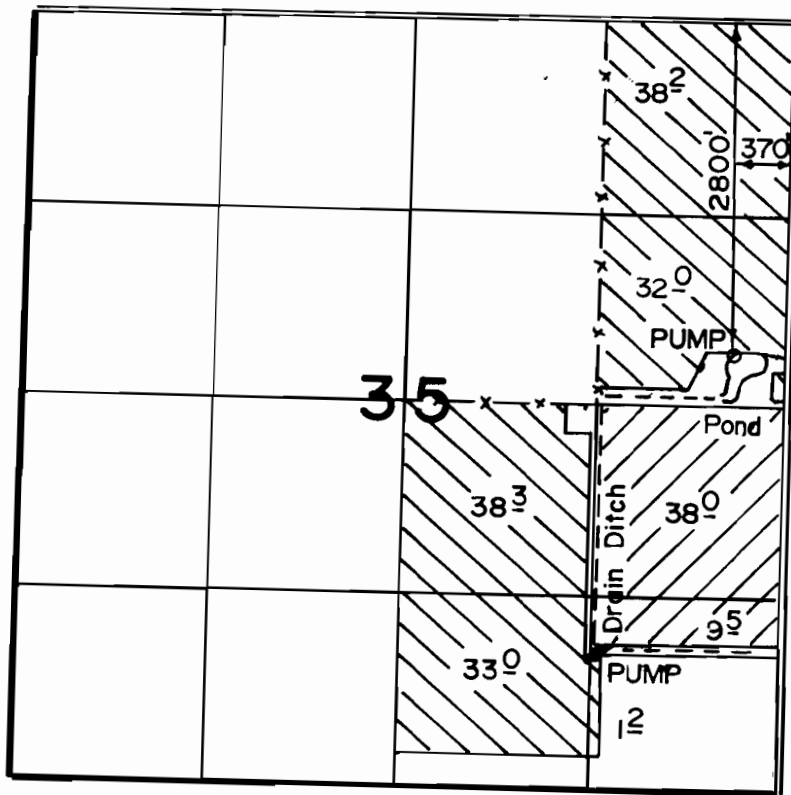

Scale 1" = 1320'



**RECEIVED**

OCT - 9 1996

WATER RESOURCES DEPT.  
SALEEM OREGON

# FINAL PROOF SURVEY

UNDER


APPL. G-12747

PER. G-11700

IN NAME OF

CECIL J. FORTIN AND IONE M. KISER

Surveyed October 5, 1996

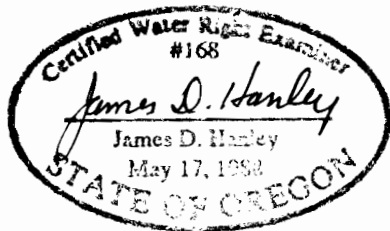

SUPP'L. IRR.



PRI. IRR

The purpose of this map is for identifying the location of the water right only and is not intended to provide legal dimensions of property ownership lines