


001110

T.10 S.R.2 W.W.M.

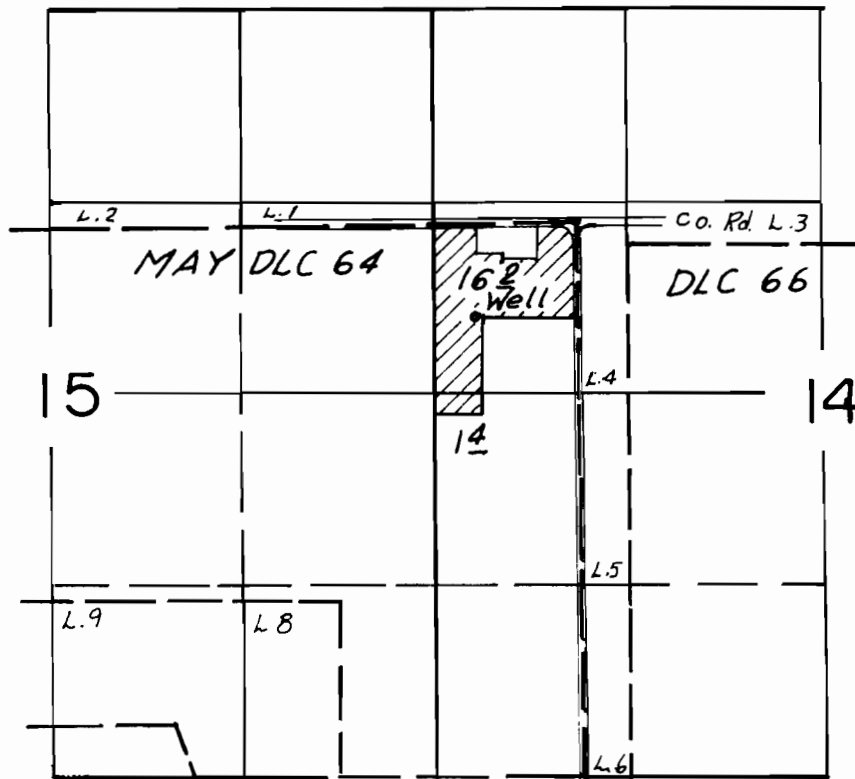

Scale
4" = 1 Mi.


Well Loc. 660' S & 700' W from NE cor DLC 64

FINAL PROOF SURVEY UNDER
Appl. No. G-13315 Per. No. G-11707 By

HOWARD & LORRAINE

STAHR

THIS MAP WAS PREPARED FOR THE
PURPOSE OF IDENTIFYING THE LOCA-
TION OF A WATER RIGHT ONLY AND IS
NOT INTENDED TO PROVIDE LEGAL
DIMENSIONS OR LOCATION OF PROPER-
TY OWNERSHIP LINES.

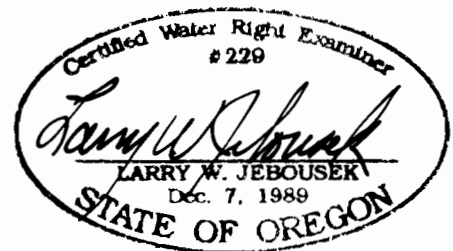

Surveyed Nov. 26, 1996

WAC-ODFW-93 5-196