



SCALE

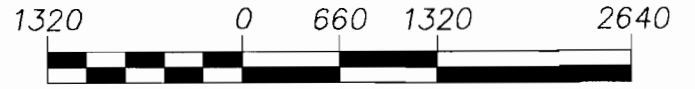

( FEET )  
1" = 1320'

5

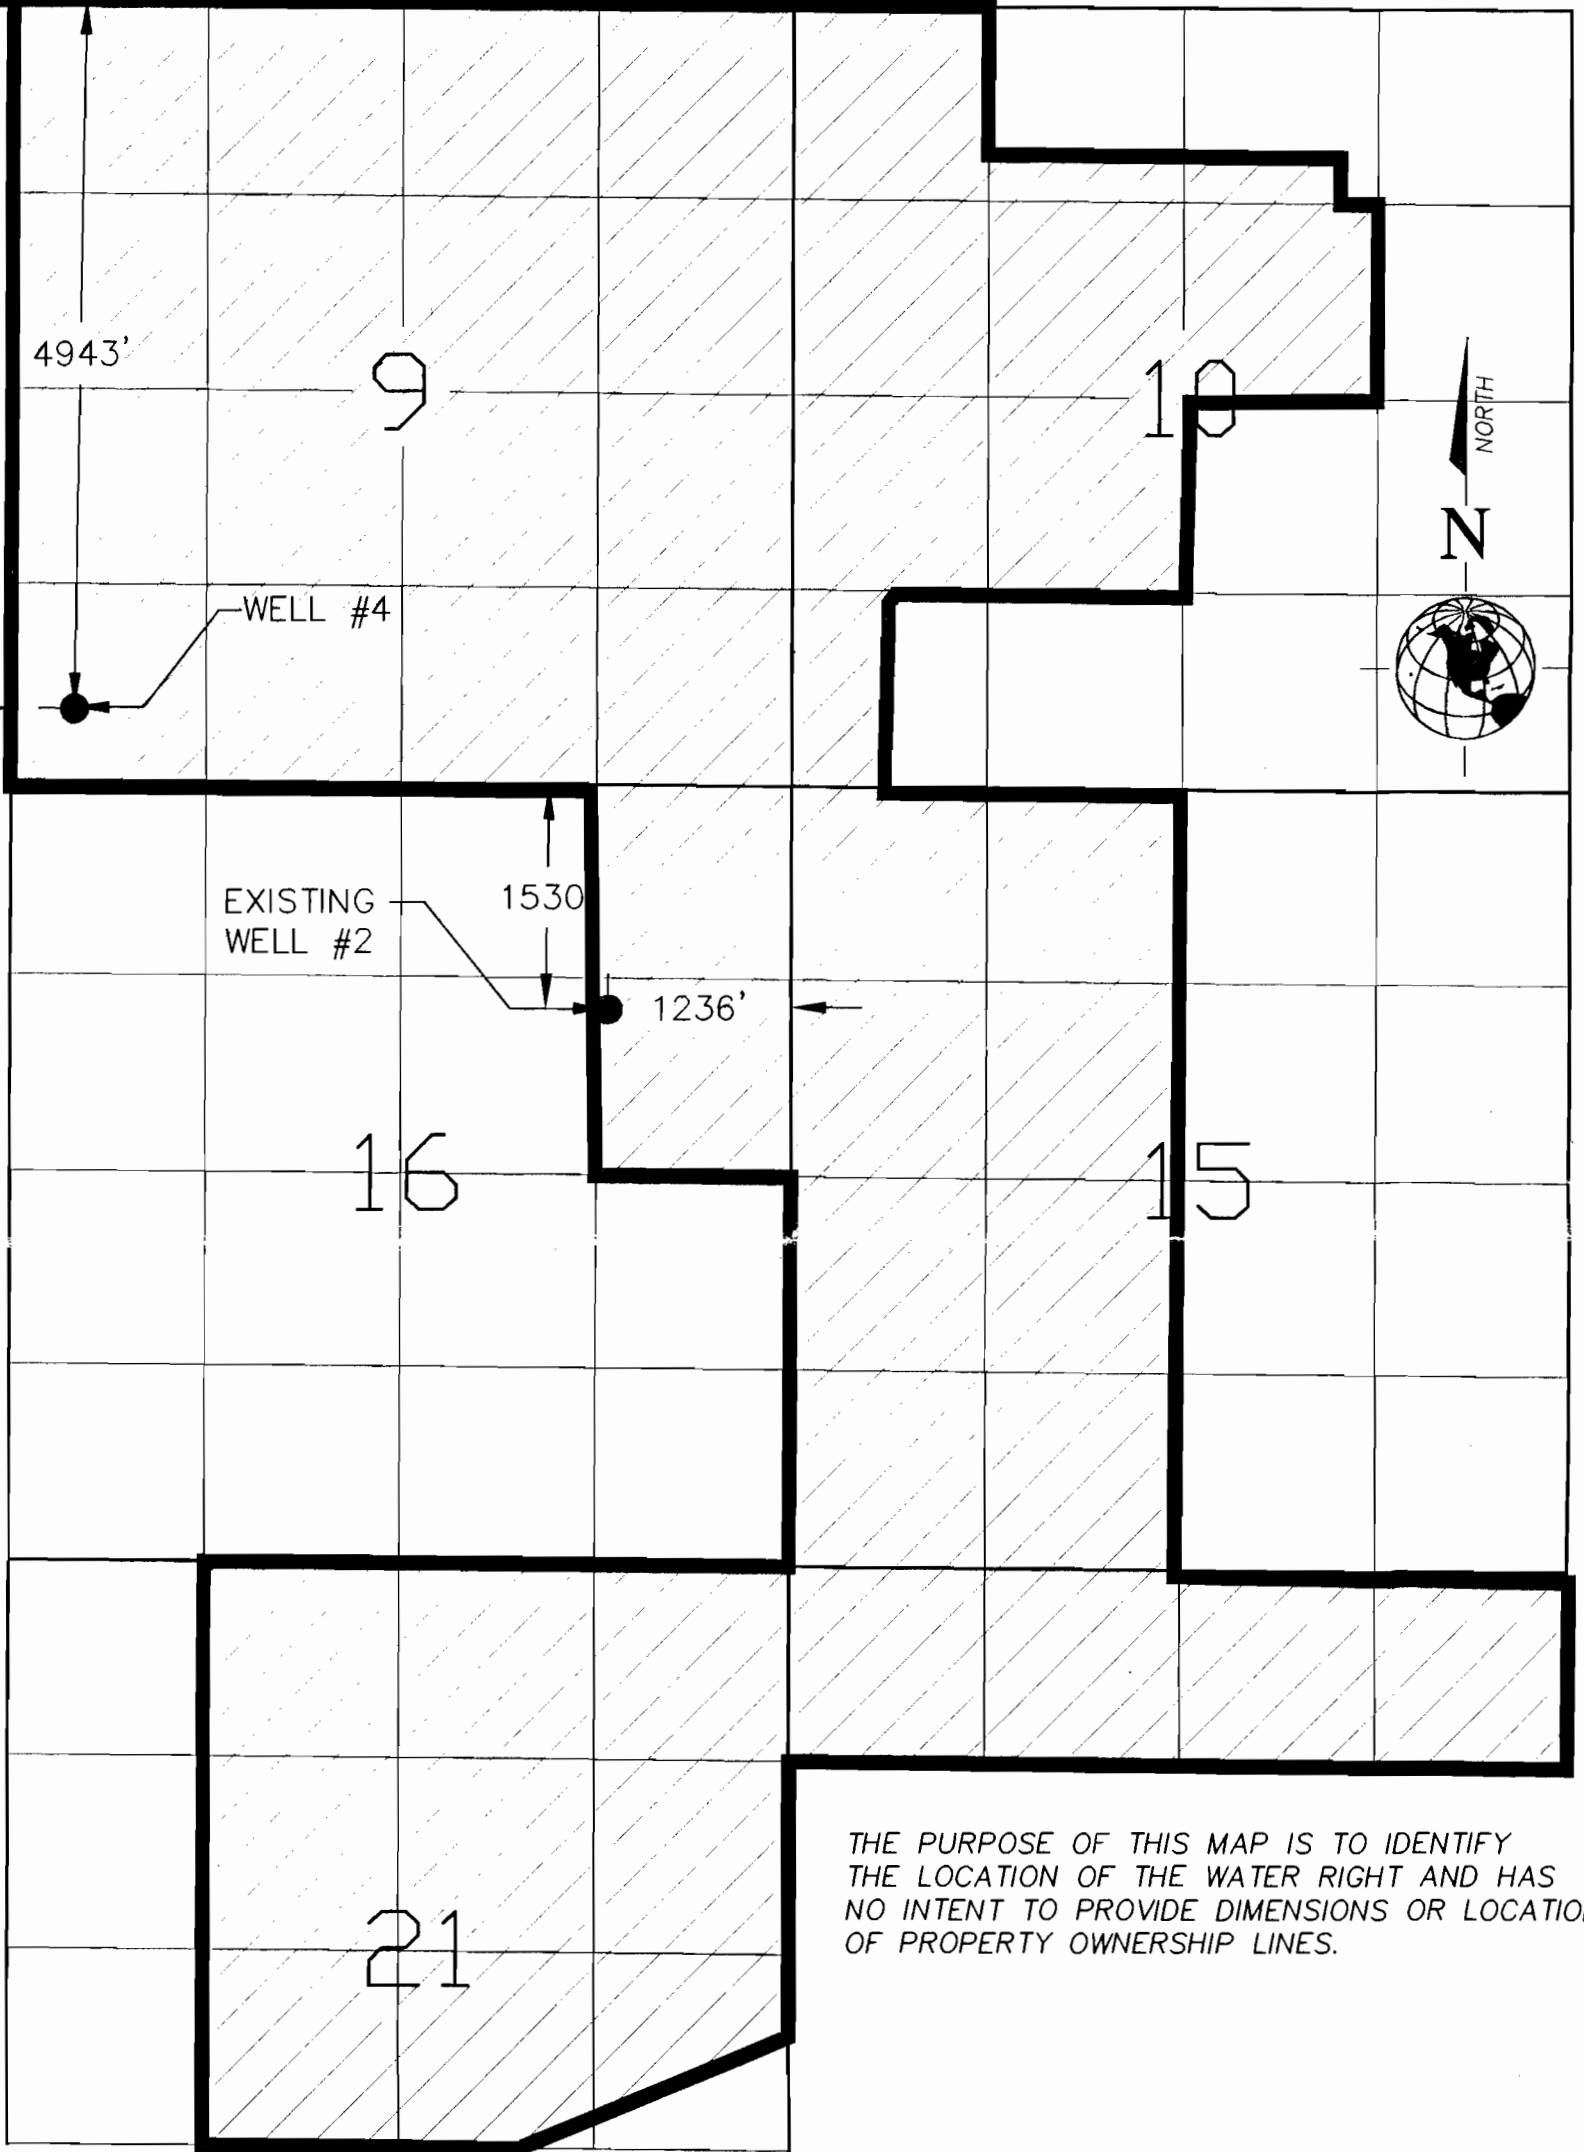

THE PURPOSE OF THIS MAP IS TO IDENTIFY THE LOCATION OF THE WATER RIGHT AND HAS NO INTENT TO PROVIDE DIMENSIONS OR LOCATION OF PROPERTY OWNERSHIP LINES.

RECEIVED

FEB 18 1999

WATER RESOURCES DEPT  

11/18/98

BLACK BUTTE RANCH ASSOCIATION  
BLACK BUTTE RANCH CORPORATION  
APPLICATION #G-12711,  
PERMIT #G-11710

SHEET  
1

DRAWN BY: JFH  
CHECKED BY:  
APPROVED BY:

**FINAL PROOF SURVEY**

BEND, DESCHUTES OREGON

SCALE: 1" = 1320' PROJECT NO. 0747.0102 FILE NAME: BBRWR.DWG

**W&HPACIFIC**  
920 SW EMKAY DR. SUITE C-100  
BEND, OREGON 97702  
WWW.WHPACIFIC.COM  
TEL: (541)388-4255 FAX: (541)388-4229  
Planning • Engineering • Surveying • Landscape Architecture