


FINAL PROOF SURVEY

T 6 S R 2 W WM.

SE ¼ SW ¼ and SW ¼ SE ¼ SECTION 9


application # G-13108 permit # G-11717

For: Terry Silbernagel

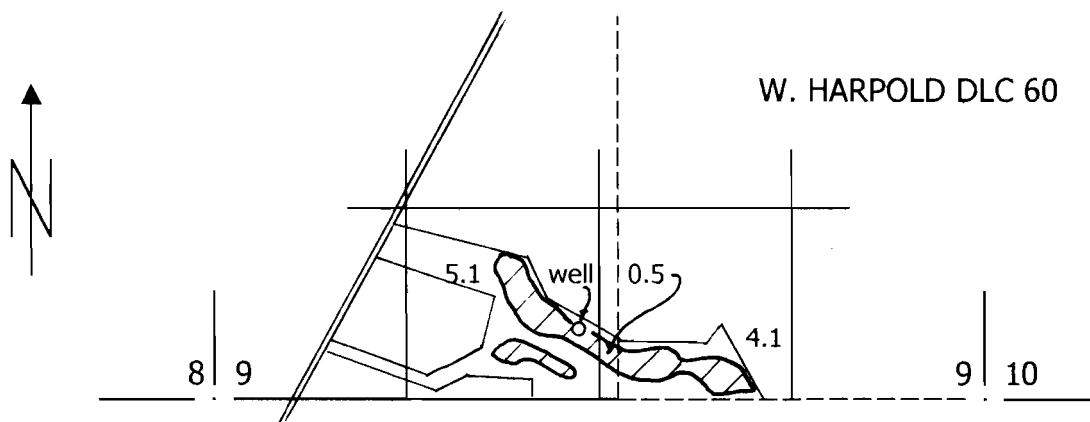

diversion point location: N 78° 45' E, 2550' from the SW corner section 9

Scale 1" = 1320'

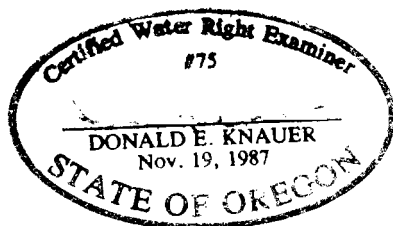

This map is to be used for water right purposes only.

Don Knauer Consulting
PO Box 5416
Salem, OR 97304
503-585-8474