

RECEIVED

T5N, R29E, W.M.,
UMATILLA COUNTY, OREGON


FINAL PROOF SURVEY

LAND RESOURCES DEPT.
SALEM, OREGON

Application No. G-13360
Permit No. G-11722


IN THE NAME OF:

Christopher J. & Sharon L. Burns
Route 3, Box 3402 Dallas Road
Hermiston, Oregon 97838-9715
Phone No. 503-567-2373

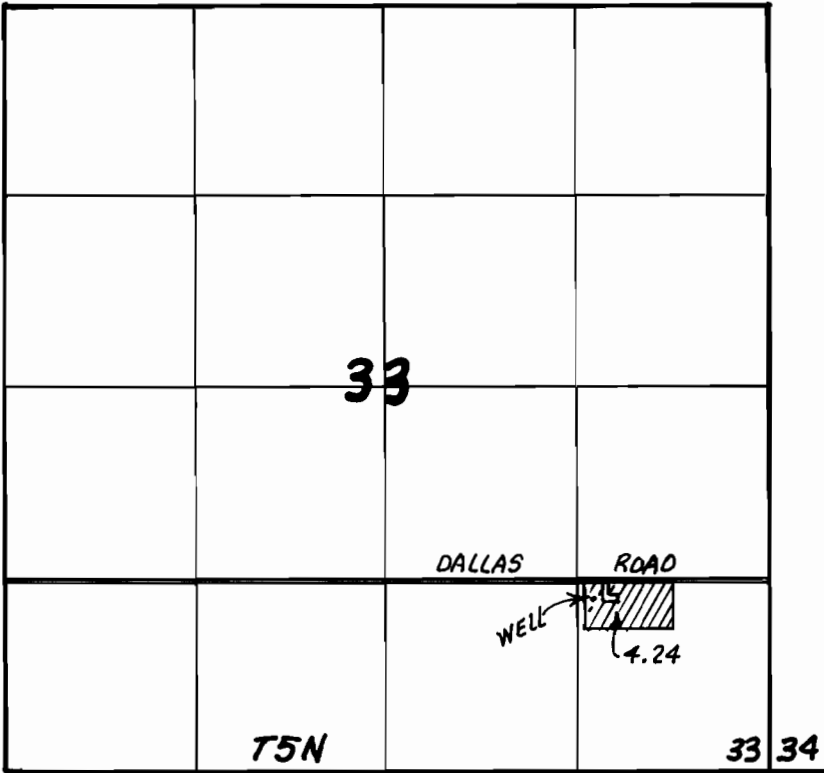

Scale: 1" = 1320'

This map is for identifying the location of water rights only and is not intended to show property lines or dimensions.

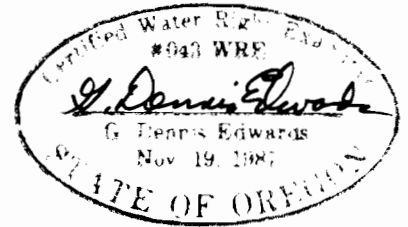

Well lies 1205' North & 1205' West of S.E. Cor. of Section 33.

Edwards Surveying P.O. Box 763
503-567-3336 Hermiston, OR. 97838
7/19/95 Job #W9303014-A