

RECEIVED


OCT 02 1998

WATER RESOURCES DEPT.  
SALEM, OREGON

# TOWNSHIP 16 SOUTH RANGE 5 WEST W.M.

**WELL LOCATION:**

The well location  
is 2294± feet south  
& 1646± feet east  
from the C 1/4  
Section 26  
T16SR5WWM

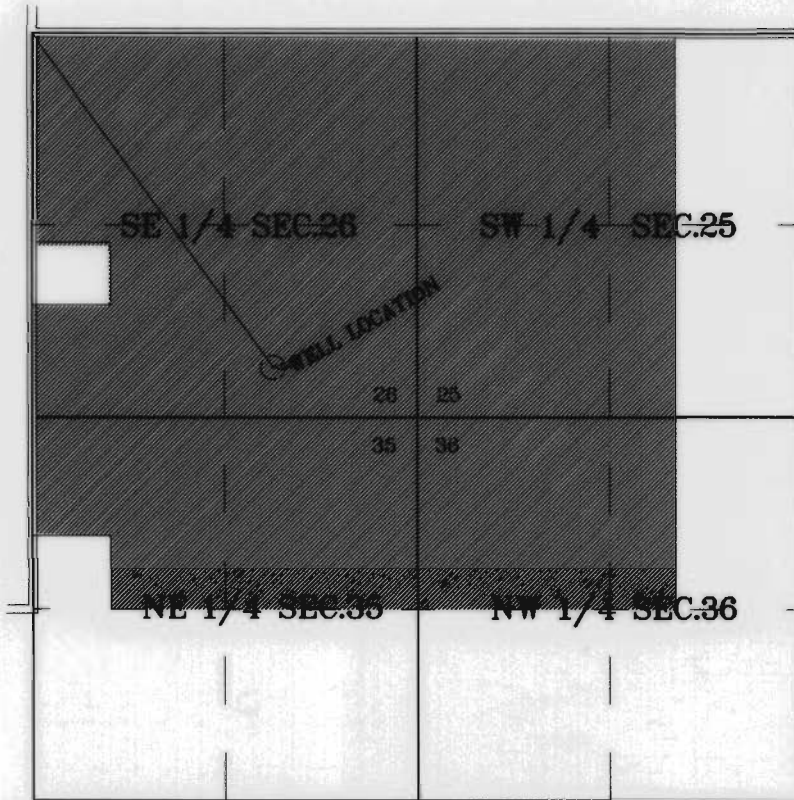

Scale 1"=1320'  
C:\CADD6\G11734

## FINAL PROOF SURVEY

under

### Appl. No. G-12858, Per. No. G-11734

COMPLETED October 1, 1998



THIS MAP WAS PREPARED FOR THE PURPOSE OF IDENTIFYING THE LOCATION OF A WATER RIGHT ONLY AND IS NOT INTENDED TO PROVIDE LEGAL DIMENSIONS OR LOCATION OF PROPERTY OWNERSHIP LINES.