


Township 7 South, Range 1 West, W.M.


Portions of Sections 8 & 9

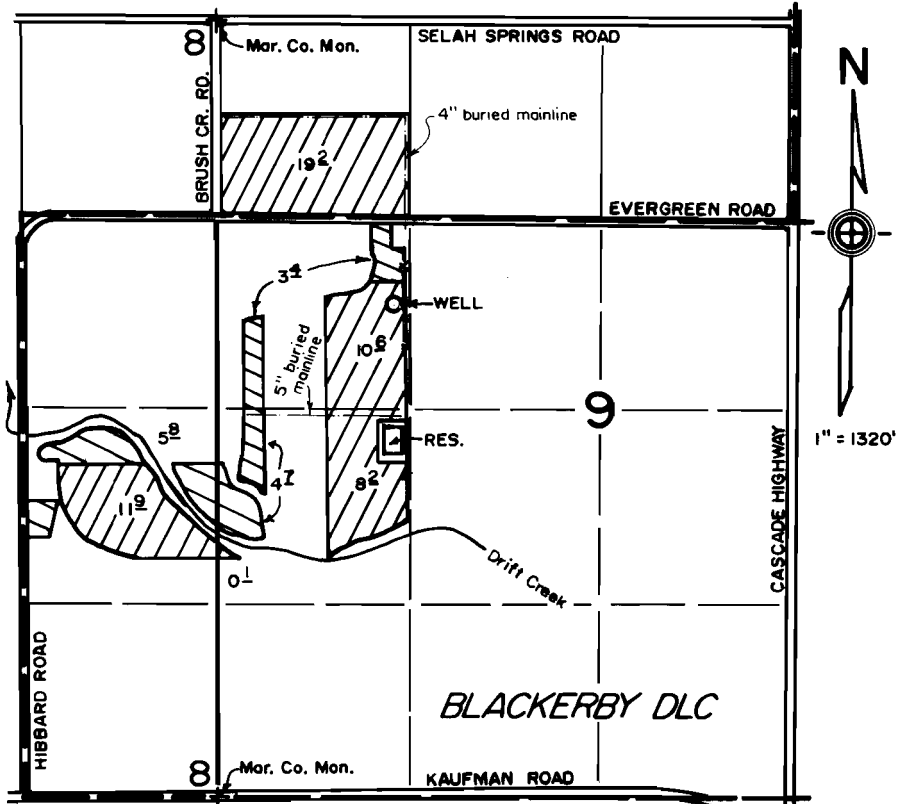

WELL LOCATED 1910' S. & 1235' E. FROM NW COR. SEC. 9

- SUPPLEMENTAL
- PRIMARY

FINAL PROOF SURVEY
 under
 Appl. No. G-12878, Per. No. G-11737
 in name of
 ALFRED VON FLUE
 Jan. 10, 1996

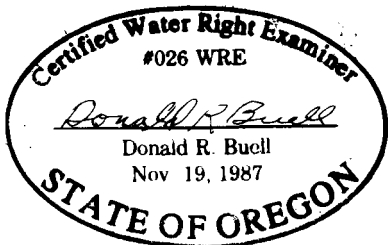

THIS MAP WAS PREPARED FOR THE PURPOSE OF IDENTIFYING THE LOCATION OF A WATER RIGHT ONLY AND IS NOT INTENDED TO PROVIDE LEGAL DIMENSIONS OR LOCATION OF PROPERTY OWNERSHIP LINES.