
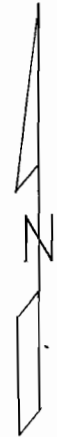


RECEIVED

OCT 12 1998

WATER RESOURCES DEPT.
SALEM, OREGON

T. 15S. R. 4 & 5 W. W. M.

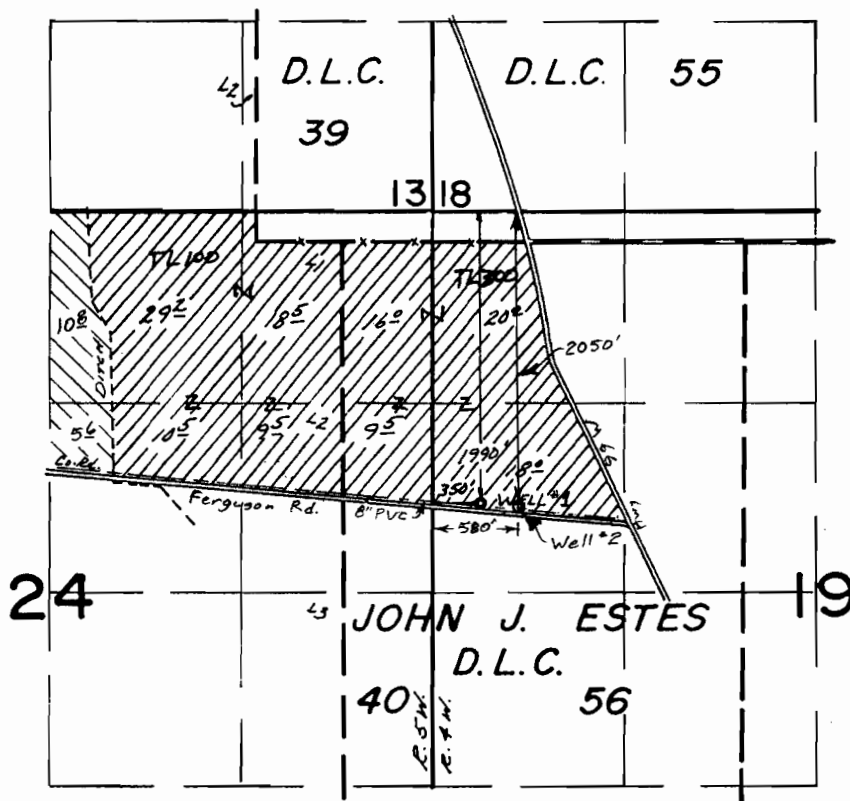

Scale 1" = 1320'


T-7254 (hatched symbol) C-49201

T-7768 (hatched symbol) App G-12974 Per G-11739

Surveyed March 26, 1998

T-7254
T-7768
App G-12974, Per G-11739

Claim of Beneficial Use Map
for
NIXON FARMS, INC.

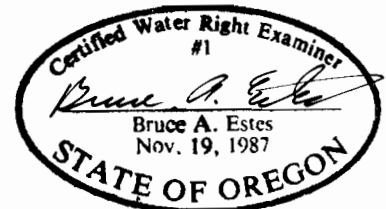

This map is for the purpose of
locating a water right only
and has no intent to provide
legal dimensions or the location
of property lines.

ESTES SURVEYS
 6293 Sunnyview Rd. NE Salem, OR 97305 (503) 585-7593
 60382 Arnold Rd. Bend, OR 97702 (503) 382-7391