T.7 S. R.2 W., W.M.

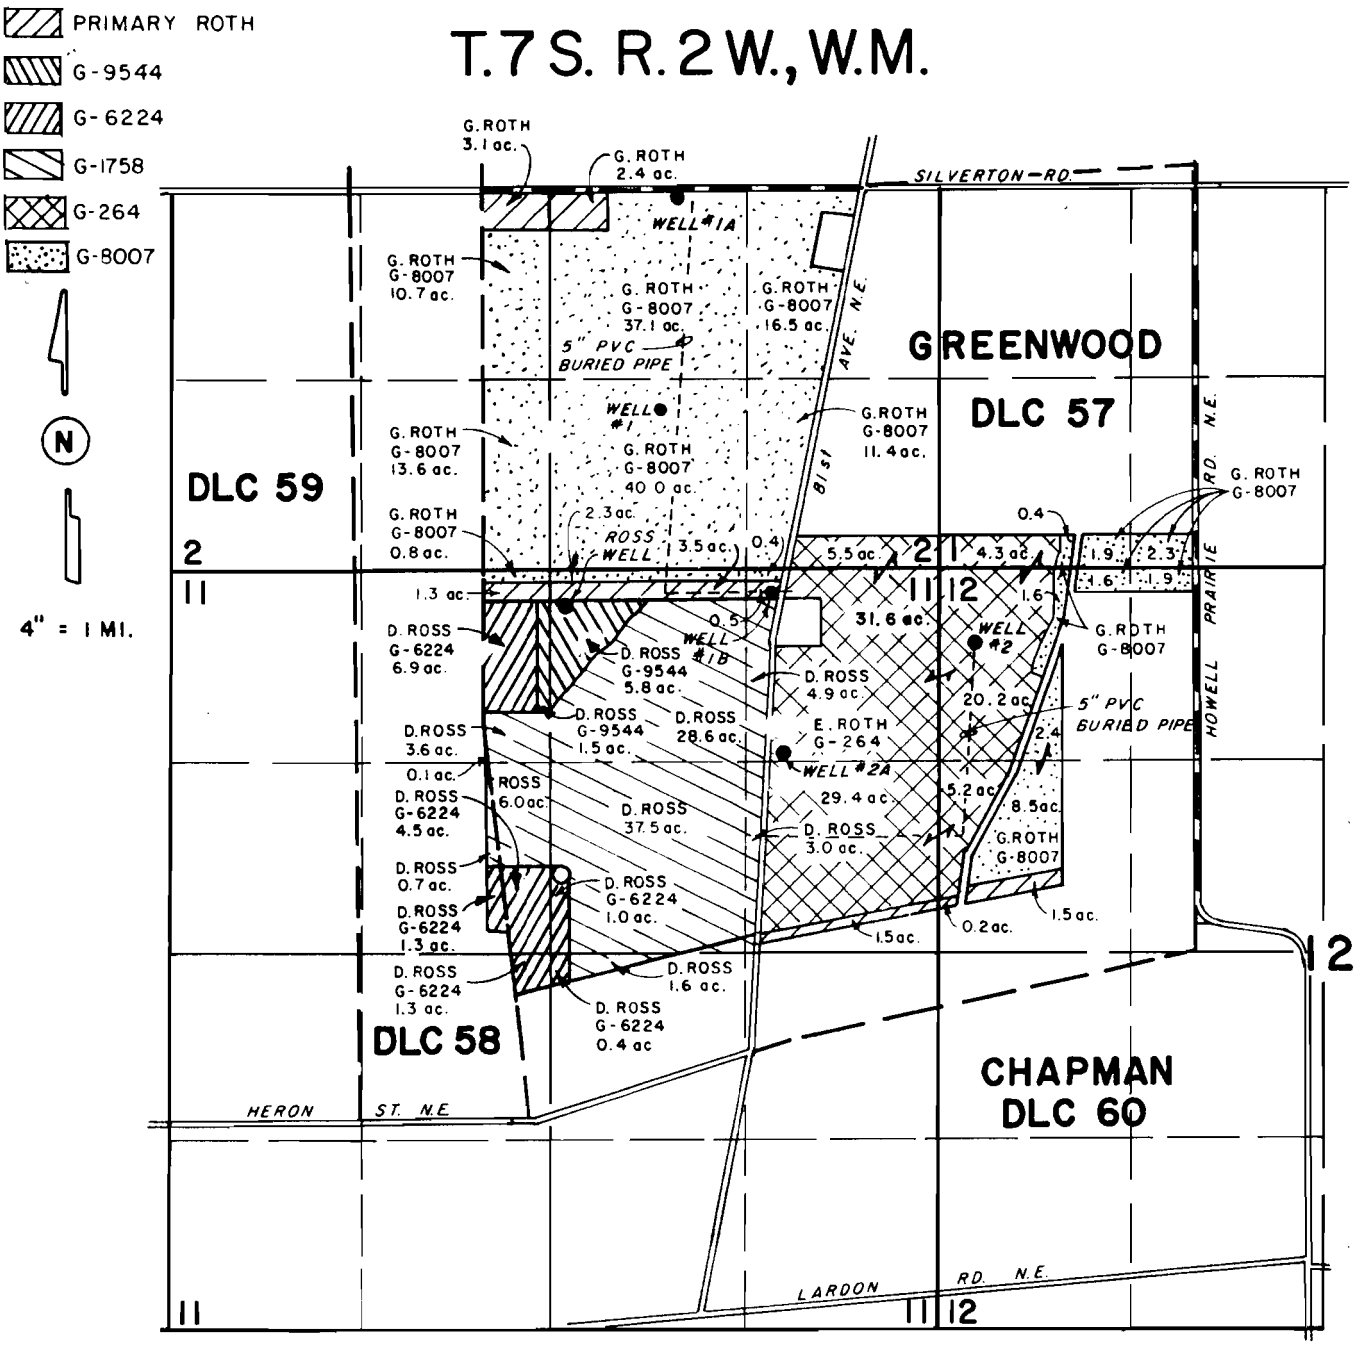

WELL LOC.:

NO. 1, 1540' S. & 1230' E. FR. NW COR. GREENWOOD DLC 57

NO. 1A, 40' S. & 1345' E. FR. NW COR. GREENWOOD DLC 57

NO. 1B, 2785' S. & 1980' E. FR. NW COR. GREENWOOD DLC 57

NO. 2, 2110' N & 1480' W. FR. SE COR. GREENWOOD DLC 57

NO. 2A, 1350' N. & 2810' W. FR. SE COR. GREENWOOD DLC 57

ROSS WELL, 3630' N. & 270' E. FR. SW COR. GREENWOOD DLC 57

WATER RIGHT MAP FOR

GERALD E. ROTH

SURVEYED ON AUGUST 21, 1990

BY: Larry W. Jelovsek

Application No. G-12305

Permit No.

SUPERSEDED 4-13-93