
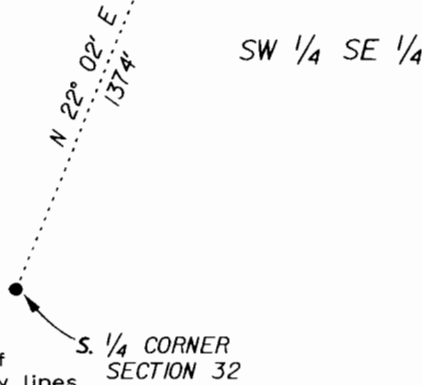


RECEIVED

JAN 21 1998

LAND RESOURCES DEPT
STATE OF OREGON


DELIVERED BY
PERMITTED

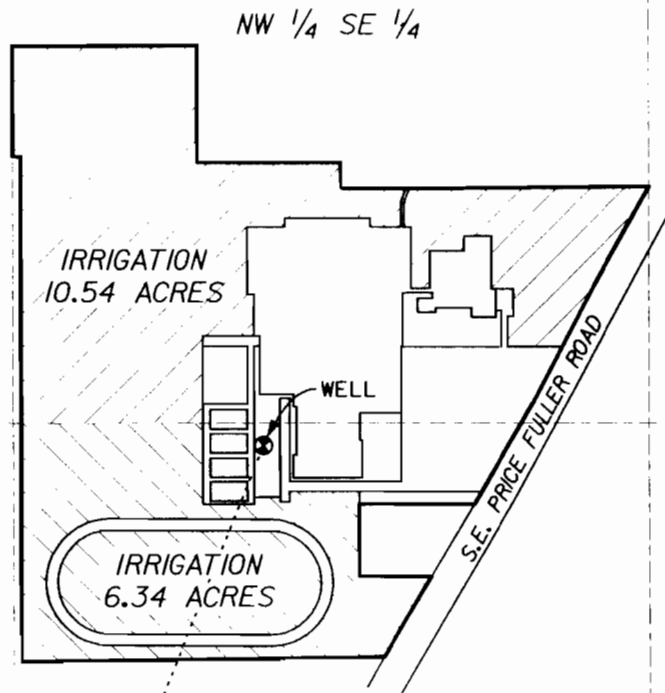

This drawing is an exhibit for a Final Proof Survey. It is not a Land Survey. Property lines and/or other lines of occupation shown hereon are not represented by the undersigned to meet accuracy standards of Land Surveys.



SCALE: 1" = 400'

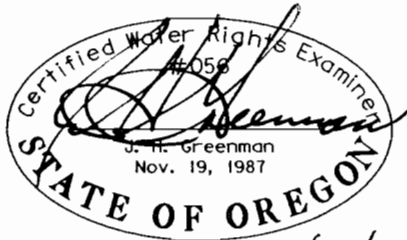


98/01/21

SECTION 32, T.1S., R.2E., W.M.
CLACKAMAS COUNTY, OREGON

Application No. G-12223

Permit No. G-11763

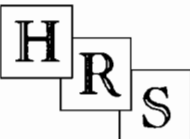

**HANER, ROSS &
SPORSEEN, INC.**
15 S.E. 82ND DRIVE
GLADSTONE, OREGON 97027

LA SALLE HIGH SCHOOL
FINAL PROOF SURVEY