


TWP 38 S R 5 WWM

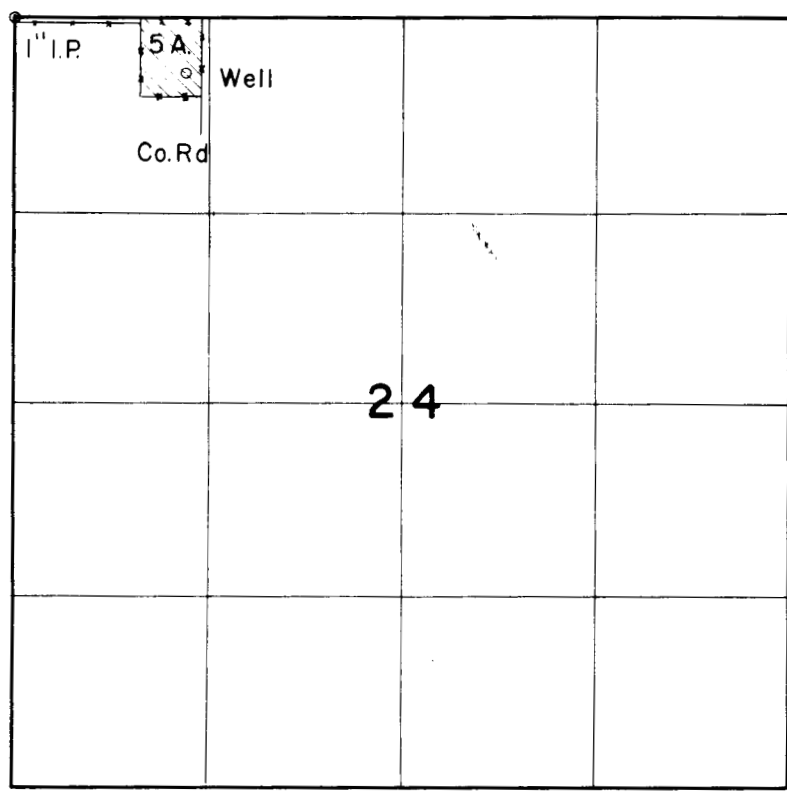

FINAL PROOF SURVEY  
UNDER

Application No. G-1109 Permit No. G-1177  
IN NAME OF

R. F. Lofland

Surveyed Oct. 26 1961 by Steimer