

T.5&6S., R.1W., W.M.

RECEIVED


RECEIVED

NOV 12 1996

MAY 22 1997


WATER RESOURCES DEPT
SALEM, OREGON

WATER RESOURCES DEPT
SALEM, OREGON

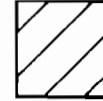

Area Irrigated

1" = 1320'

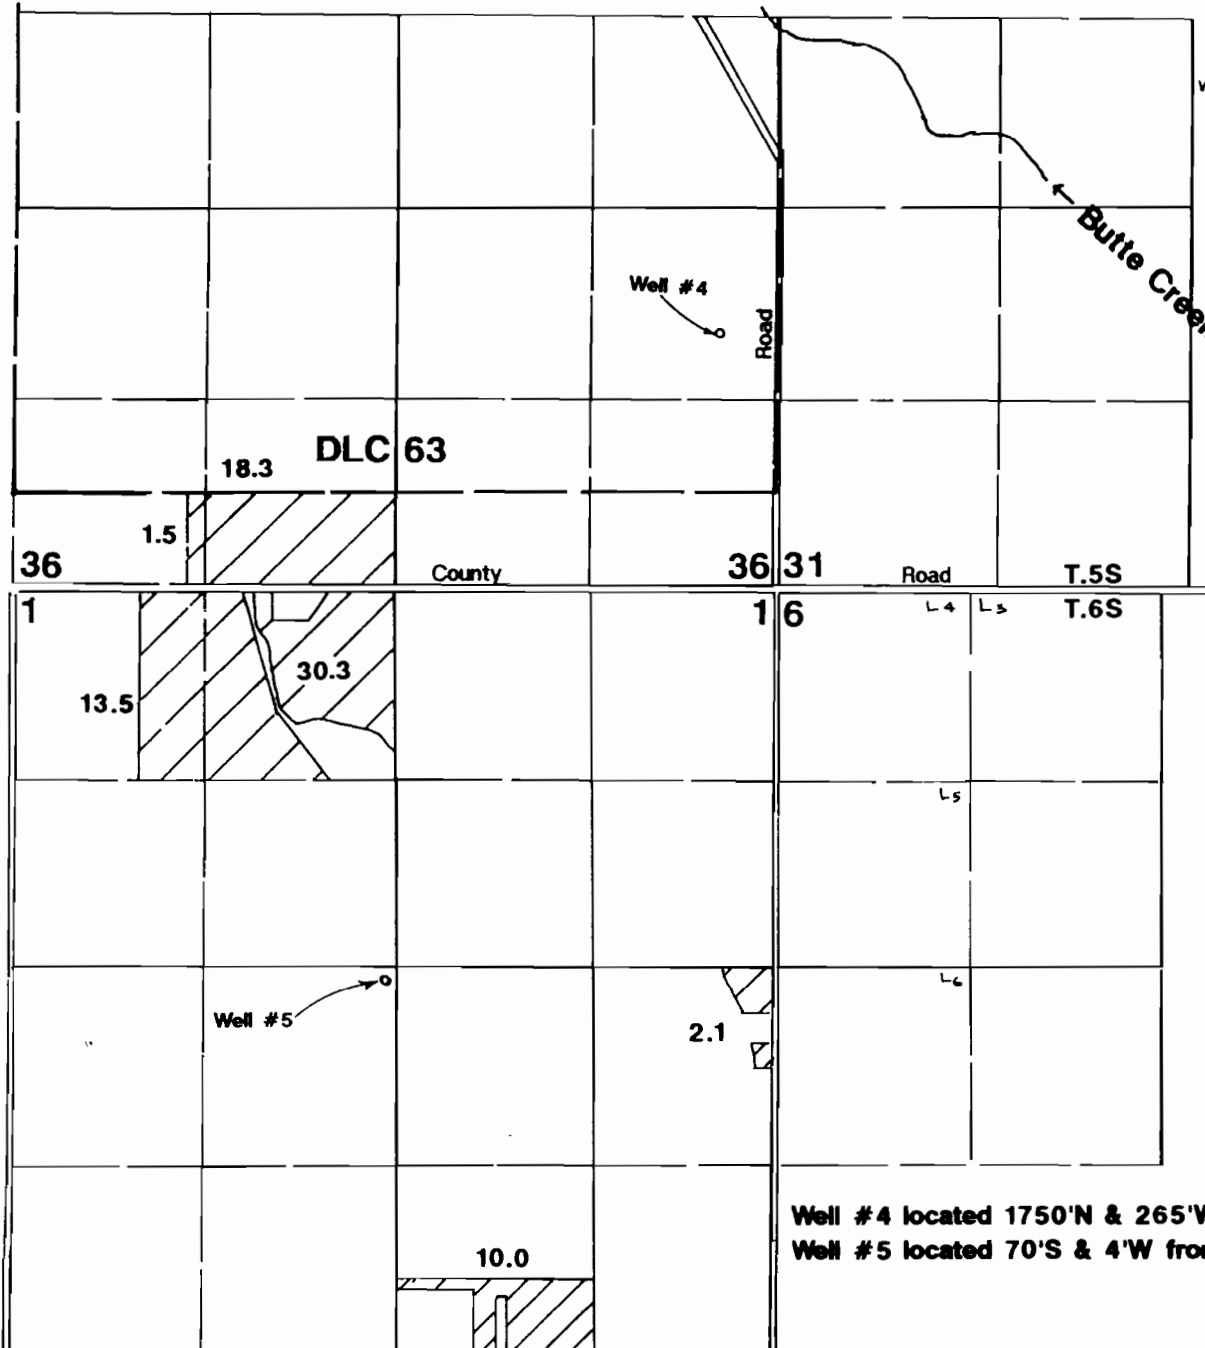

Final Proof Survey

Application #: G-12719 Permit #: G-11772

In Name Of

James Butsch

Surveyed on September 9, 1996 by JM Schuette

Well #4 located 1750'N & 265'W from SE corner Section 36.

Well #5 located 70'S & 4'W from center of Section 1.

THIS MAP WAS PREPARED FOR THE PURPOSE OF IDENTIFYING THE LOCATION OF A WATER RIGHT ONLY AND IS NOT INTENDED TO PROVIDE LEGAL DIMENSIONS OR LOCATION OF PROPERTY OWNERSHIP LINES.