
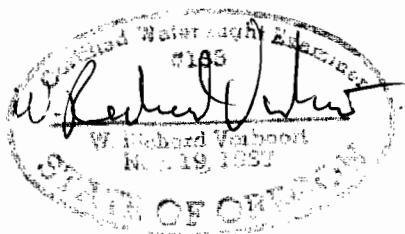


NW 1/4 SECTION 2, T.15., R.3W., W. M.  
WASHINGTON COUNTY OREGON

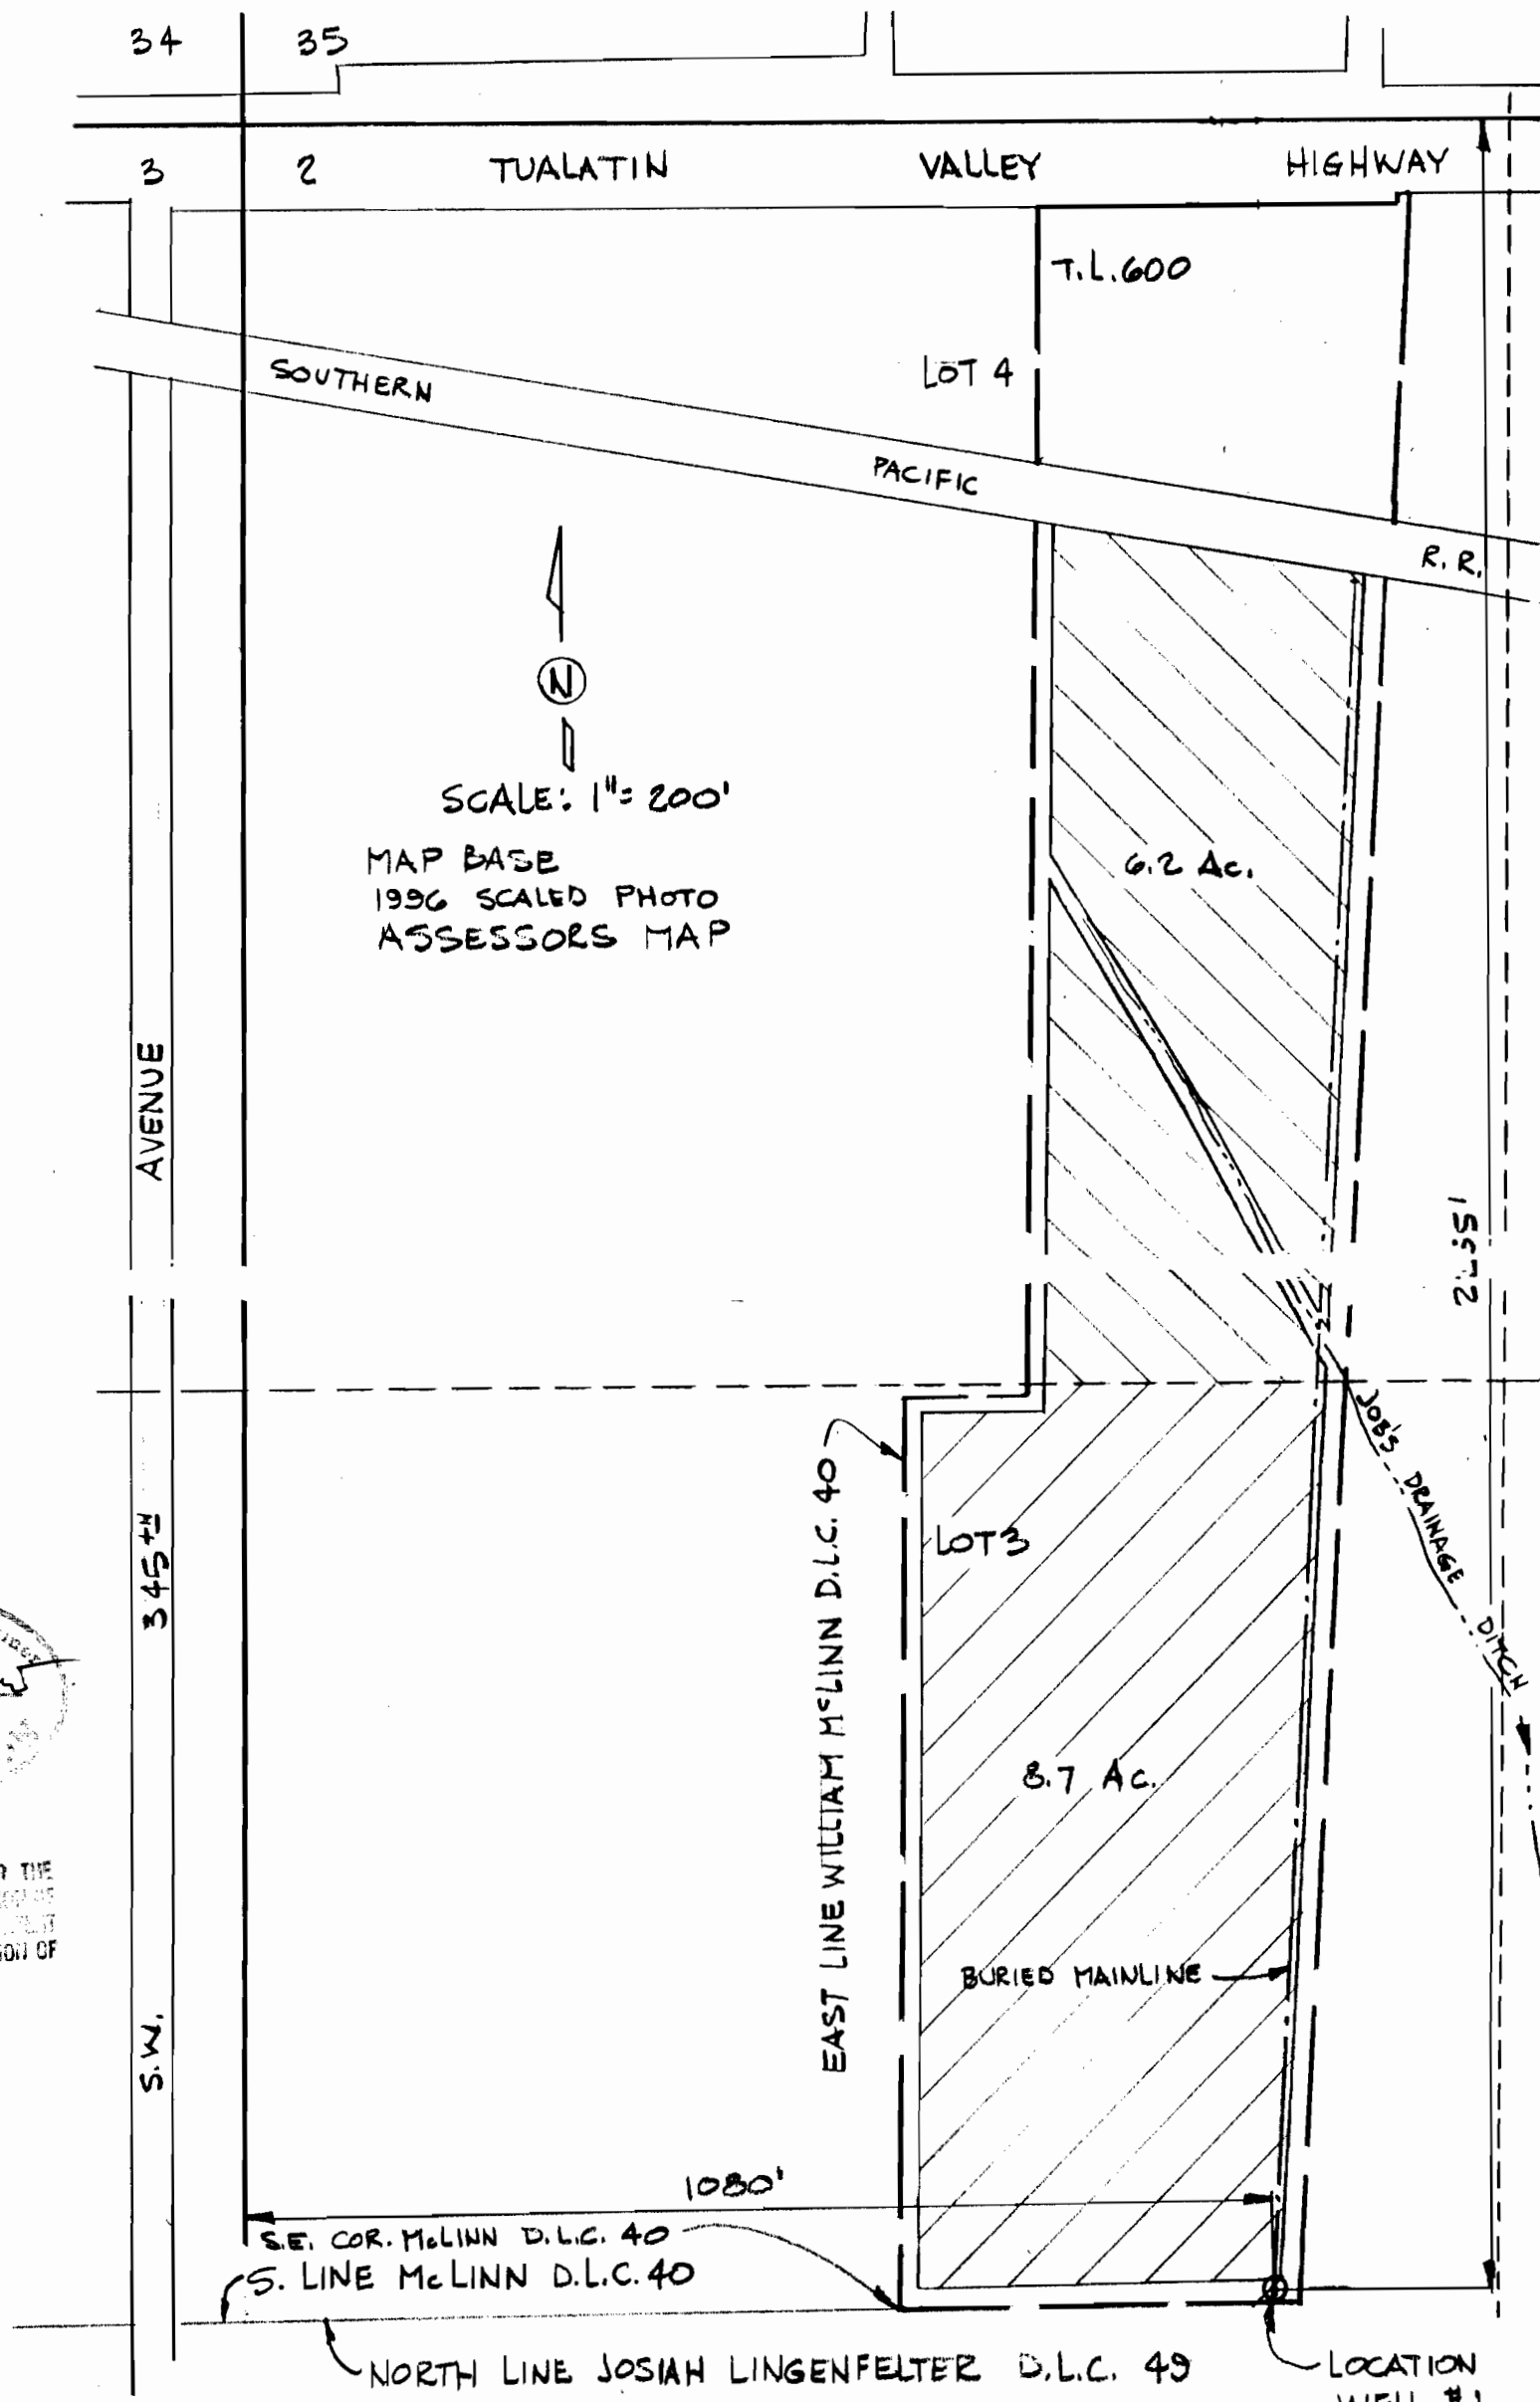


**FINAL PROOF SURVEY**  
APPLICATION G-13196 PERMIT G-11777  
SURVEYED 12.19.96

**VERBOORT ENGINEERING**  
AGRICULTURE • CIVIL • WATER RESOURCES  
HILLSBORO, OREGON

	by	date
designed	WRV	12.19.96
drawn	JER	12.19.96
checked	WRV	12.19.96
drawing no.	96-B-14	
sheet no.	1/1	

**JON & WENDY OLSON**  
20580 S.W. WESTSIDE STREET  
ALOHA, OR 97007