


SEC. 23, T.4S, R.1E, W.M.

WATER RESOURCES DEPT
SALEM, OREGON

NOTE:

THIS MAP WAS PREPARED FOR THE PURPOSE OF IDENTIFYING THE LOCATION OF THE WATER RIGHT ONLY AND HAS NO INTENT TO PROVIDE DIMENSIONS OR LOCATION OF PROPERTY OWNERSHIP LINES.

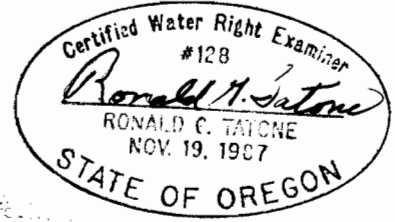

3" LATERALS
@ 30' C-C
(TYPICAL)

14
23
NORTH
1/4 CORNER

T.L. 600

N.E. 1/4
N.W. 1/4
15.64 Ac.

1235

S. MACKSBURG RD.

T.L. 1100

WELL

215'

T.L. 1490

N.W. 1/4
N.E. 1/4
4.48 Ac.

3" LATERALS
@ 30' C-C
(TYPICAL)

T.L. 1400

S.W. 1/4
N.E. 1/4
12.78 Ac.

S.E. 1/4
N.W. 1/4
19.25 Ac.

DOVE CREEK



LEGEND

- INDICATES BURIED MAIN,
- INDICATES SURFACE MAIN.
- INDICATES SURFACE LATERAL.

SCALE - 1" = 400'

**FINAL PROOF SURVEY
FOR
RUDY ETZEL
C/O NAT ETZEL**

T.L. 2000

T.L. 1480

N.W. 1/4
S.E. 1/4
26.67 Ac.

3" LATERALS
@ 30' C-C
(TYPICAL)

APPLICATION NO. G-13279

PERMIT NO. G-11778

ZTec ENGINEERS, INC.

3737 S.E. 8TH AVE., PORTLAND, OR. 97202
PHONE: (503) 235-8795
FAX: (503) 233-7889