


new 6-18-90

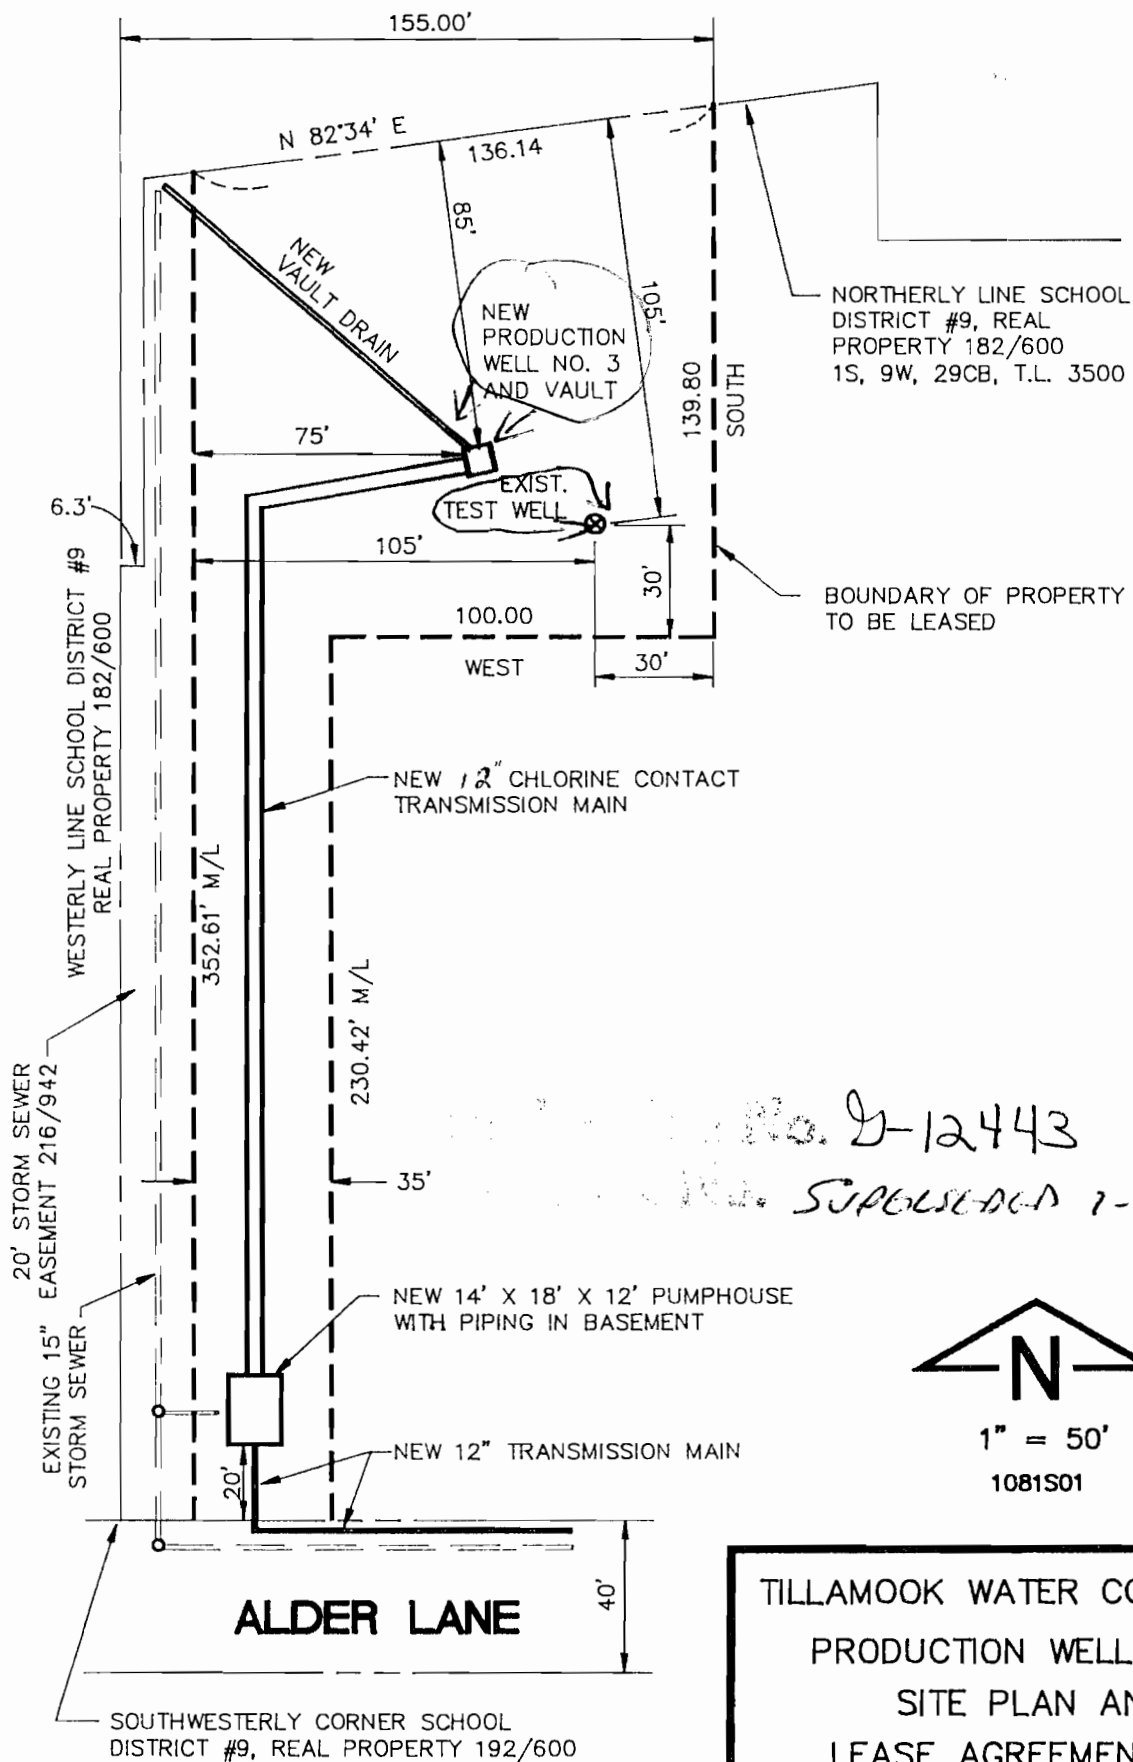

1" = 50'

1081S01

TILLAMOOK WATER COMMISSION
PRODUCTION WELL NO. 3
SITE PLAN AND
LEASE AGREEMENT MAP

LEE ENGINEERING, INC.

6/15/90