


T 24 S, R 32 E, WM

REVISIONS

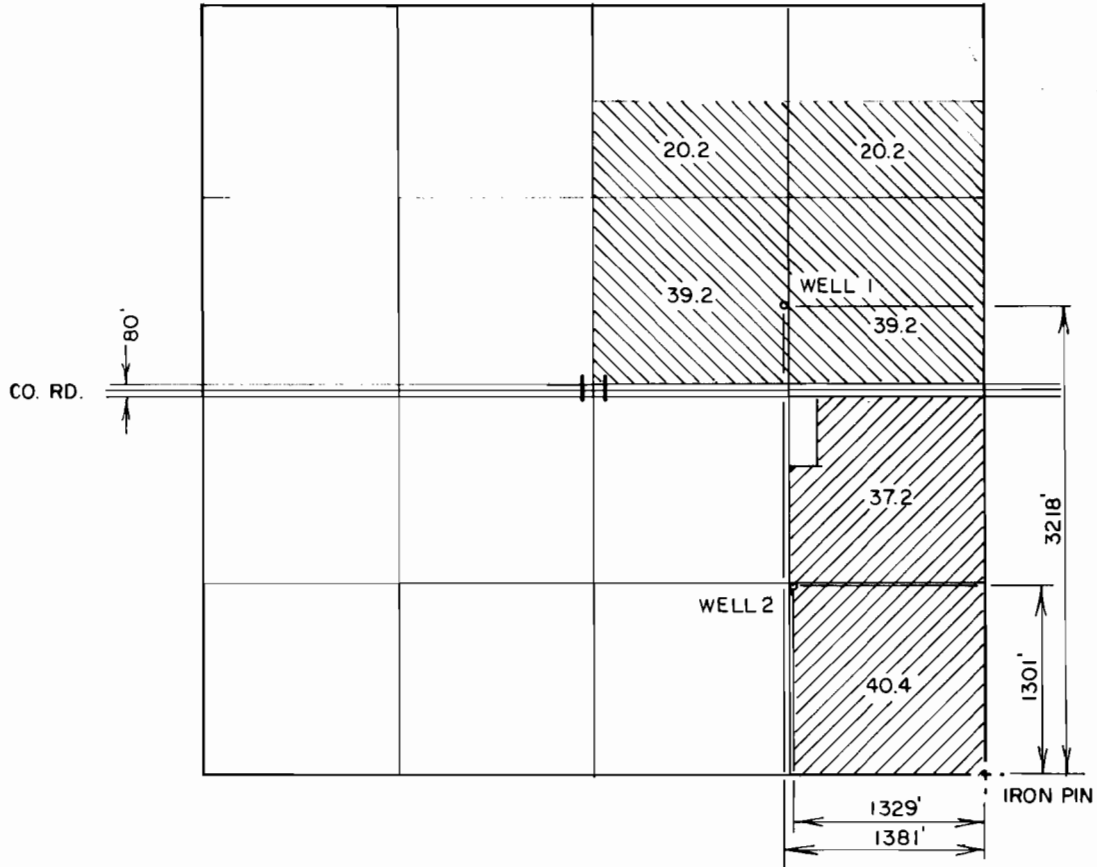

THIS SURVEY WAS MADE TO
 DETERMINE THE LOCATION OF
 THE CENTERLINE OF THE ROAD
 SHOWN ON THIS PLAN AND TO
 SHOW THE LOCATION RELATIVE
 TO THE SURFACE OF PROPERTY
 OWNERSHIP

FINAL PROOF SURVEY

UNDER
 APPLICATION G-12463
 PERMIT G-11785

IN THE NAME OF
 CURTIS J. BLACKBURN

Scale: 4" = 1 MILE

Date: JAN. 1996

Job: 1295

Dsn:

Drn: CHRIS

Ckd:



M. A. PALMER & SONS, INC.
 ENGINEERING & SURVEYING
 254 N. Alder - Box 61
 Burns, Oregon 97720

Sht. No.

of 1

