


This drawing is an exhibit for a Final Proof Survey. It is not a Land Survey. Property lines and/or other lines of occupation shown hereon are not represented by the undersigned to meet accuracy standards of Land Surveys.

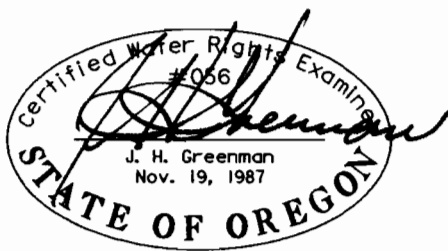


SCALE: 1" = 400'

SECTION 10, T.2S., R.4E., W.M.  
CLACKAMAS COUNTY, OREGON



Application No. G-13380

Permit No. G-11792

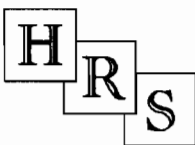

**HANER, ROSS &  
SPORSEEN, INC.**  
15 S.E. 82ND DRIVE  
GLADSTONE, OREGON 97027

**PATTERSON NURSERY INC.**  
**AMENDED FINAL PROOF SURVEY**

630CC