


SCALE: 1"=400'  
 MAP BASE:  
 COUNTY ASSESSORS  
 MAP, WAC PHOTO  
 & OWNER  
 PROVIDED MAP

PREPARATION OF THIS MAP IS FOR THE  
 PURPOSE OF IDENTIFYING THE LOCATION OF  
 THE WATER RIGHT ONLY. THERE IS NO INTENT  
 TO PROVIDE DIMENSIONS OR LOCATION OF  
 PROPERTY OWNERSHIP LINES

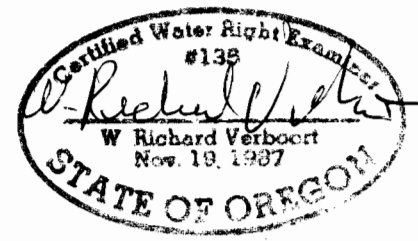

SECTION 36, T.2N., R.3W., W.M.  
 WASHINGTON COUNTY, OREGON  
**FINAL PROOF SURVEY**  
 SURVEYED SEPT. 25, 1998  
 UNDER  
 APPLICATION G-12976  
 PERMIT G-11793

PUMPKIN RIDGE JOINT VENTURE  
 669 PUMPKIN RIDGE GOLF CLUB  
 12930 OLD PUMPKIN RIDGE ROAD  
 CORNELIUS, OR 97113

designed	WRV	9-25-98
drawn	JER	9-25-98
checked	WRV	9-25-98
drawing no.	98-B-07	
sheet no.	1/1	

**VERBOORT ENGINEERING**  
 AGRICULTURE-CIVIL-WATER RESOURCES  
 HILLSBORO, OREGON