T. 5 S. R. 1 W., W.M.

RECEIVED
MAY 2 5 1998
WATER RESOURCES DEPT
SALEM, OREGON

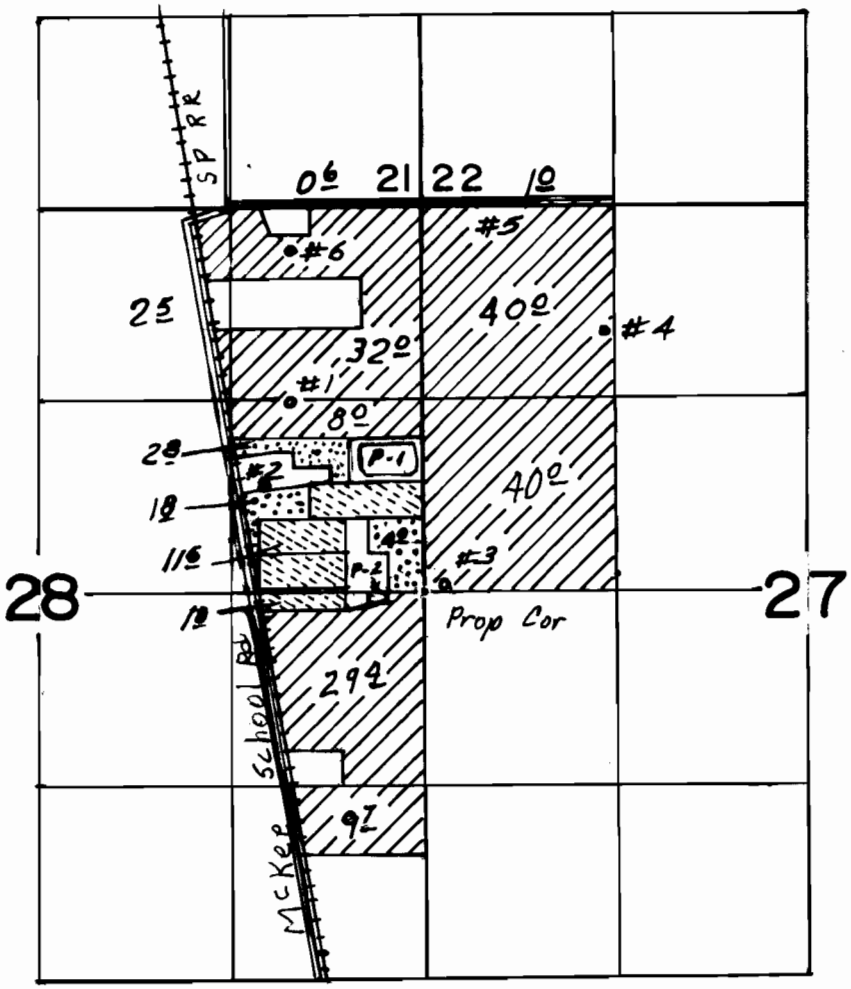

N

Scale
4" = 1 Mi.

Wells located:
#1 1300'N & 920'W
#2 730'N & 1080'W
#3 50'N & 130'E
#4 1785'N & 1250'E
#5 2670'N & 400'E
#6 2350'N & 900'W
All from E¼ Cor.
Sec. 28

	Green Houses	13.4 ac.
	Can Yards	8.6 ac.
	Irrig. & Inground Nur.	63.2 ac.

FINAL PROOF SURVEY
UNDER

Application No. G-12004 Permit No. G-11807
IN NAME OF
ROBERT FESSLER

Surveyed Mar. 6 19 98, by Larry W. Jebousek

Certified Water Right Examiner
229WRE
Larry W. Jebousek
Dec 7, 1989
STATE OF OREGON

THIS MAP WAS PREPARED FOR THE PURPOSE OF IDENTIFYING THE LOCATION OF A WATER RIGHT ONLY AND IS NOT INTENDED TO PROVIDE LEGAL DIMENSIONS OR LOCATION OF PROPERTY OWNERSHIP LINES.

WAC 92 7C-6