


0502-00

SEP 30 1997

WATER RESOURCES DEPT
SALEM, OREGON

T23S, R32E, WM

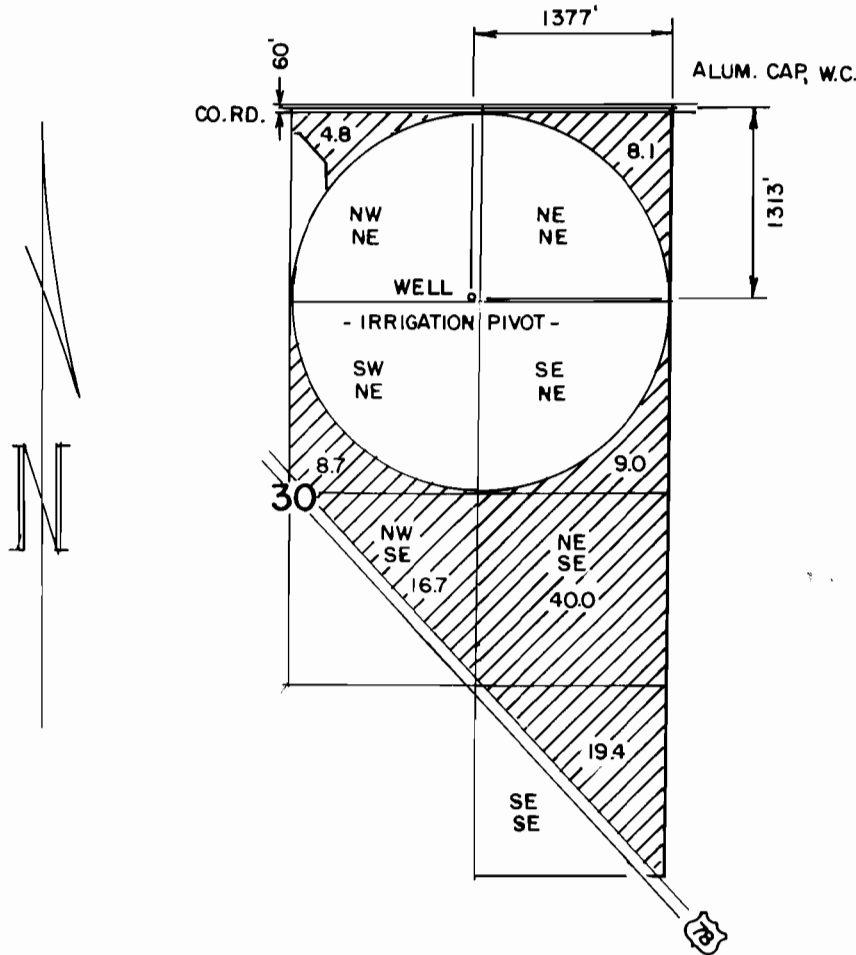

FINAL PROOF SURVEY

UNDER
APPLICATION NO. G-13201
PERMIT NO. G-11830

IN THE NAME OF
JOHN PIERRE WATTS, ERNA ETHEL WATTS,
AND LINDA K. WATTS

Scale: 4" = 1 MILE

Date: SEPT. 18, 1997

Job: 1427

Dgn:



M. A. PALMER & SONS, INC.
ENGINEERING & SURVEYING
254 N. Alder - Box 61
Burns, Oregon 97720

Sht. No.

Drn: CHRIS

Ckd:

of 1

CP Watts

RENEW 1-1-1999