


TOWNSHIP 5 SOUTH, RANGE 1 WEST, W.M.

SECTION 36

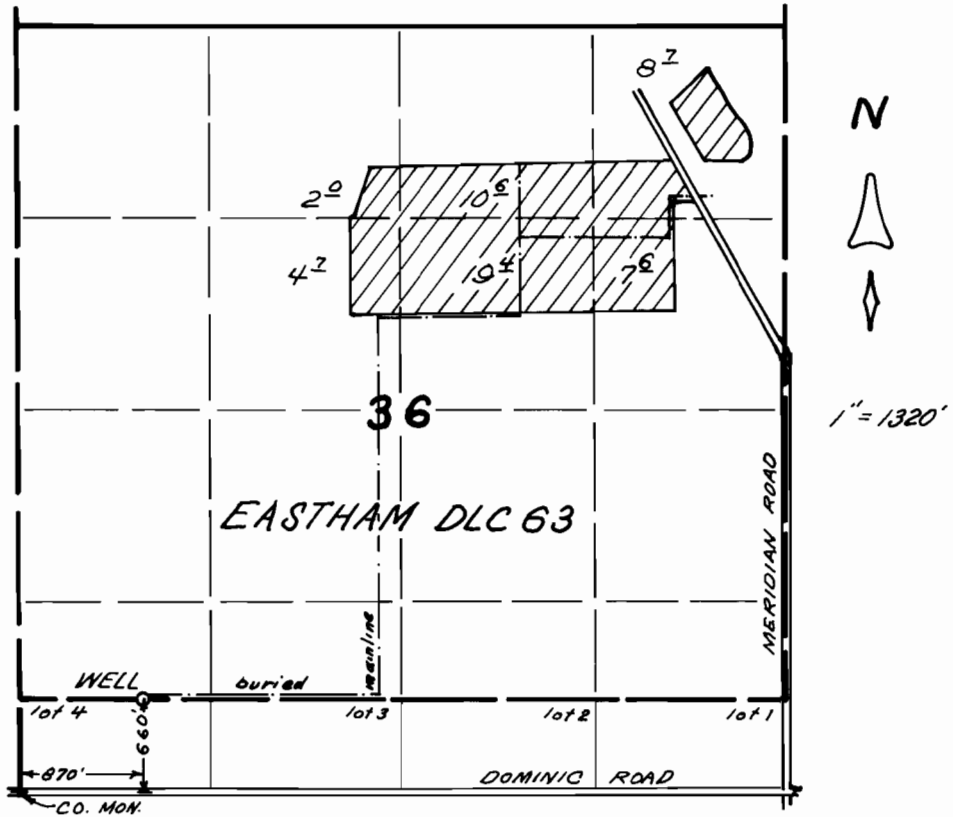

FINAL PROOF SURVEY
UNDER
APPL. No. G-13070, PER. No. G-11838
IN NAME OF
DAN HAMMELMAN
OCT. 22, 1997



THIS MAP WAS PREPARED FOR THE PURPOSE OF IDENTIFYING THE LOCATION OF A WATER RIGHT ONLY AND IS NOT INTENDED TO PROVIDE LEGAL DIMENSIONS OR LOCATION OF PROPERTY OWNERSHIP LINES.