

FINAL PROOF SURVEY

T.33 S., R.18 E., W.M.

RECEIVED

Under
Application No. G-13149
Permit No. G-11845

7-94

This map was prepared for the purpose of identifying the location of a water right only and is not intended to provide legal dimensions or location of property ownership lines.

WATER RESOURCES DIVISION
SALEM, OREGON


Well Data
Pump Model - Grundfos
7 1/2 HP; 3 phase; 230 volt
3" galvanized pipe
110 gals/min.

Brass Capped Iron Pipe
set by Lake County Surveyor
in north fill slope of County
Road.


T33S
R18E R19E
S24 T33S
1992
PLS 1664

NE1/4NE1/4
SEC. 25

The well is located S.05°20'21"W,
1358 ft. from the NE section corner of
Section 25, T.33 S., R.18 E., W.M.
The SW corner of the concrete vault
is S.03°49'11"W, 1443 ft. from
said corner. The vault is 24 ft. x 9.5 ft.
Location based on mapping grade GPS.

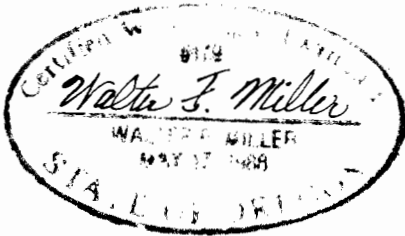

8/17/99

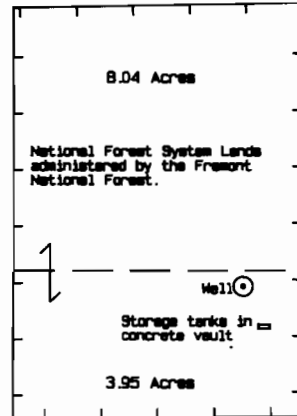

SE1/4NE1/4
SEC. 25

1/4

S.25 | S.30

See Lake County
Surveyors' records



GRAPHIC SCALE

1" = 400'

