


T.5S., R.2W., W.M.

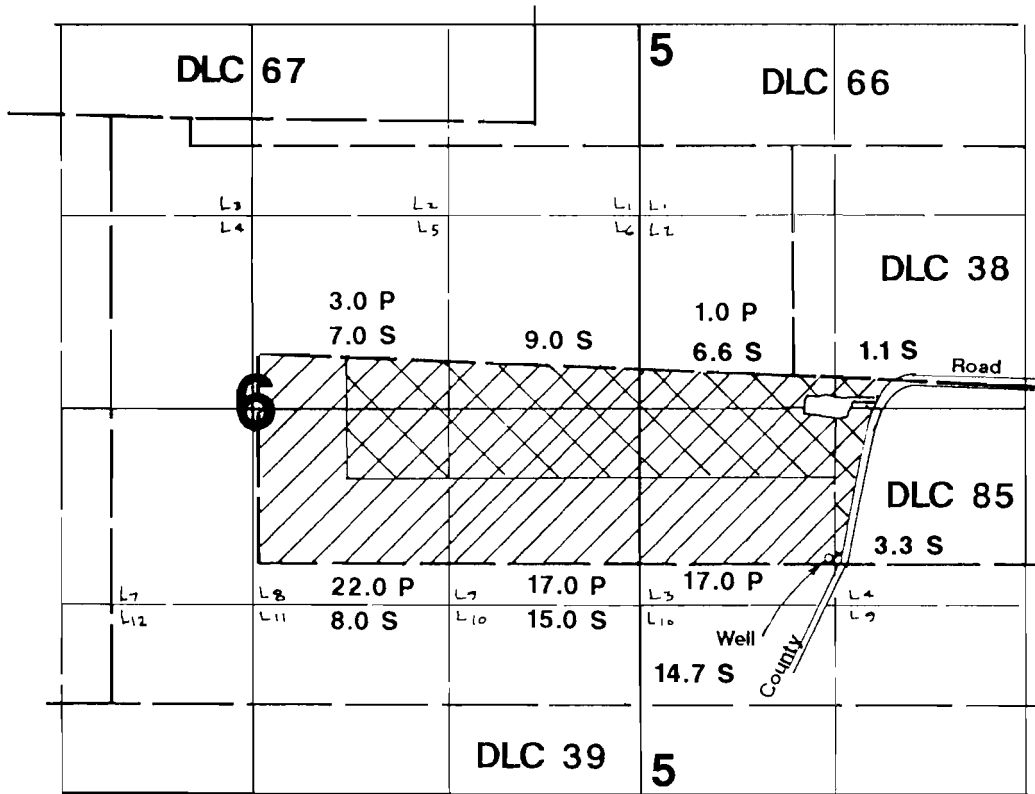

1" = 1320'

Area Irrigated



Primary



Supplemental

Well located 1650'N & 1300'E from SE corner Section 6.

Final Proof Survey

Application #: G-13366 Permit #: G-11849

In Name Of

Circle V Farms

Surveyed on August 29, 1996 by JM Schuette

SEP 18 1996

SEP 18 1996

THIS MAP WAS PREPARED FOR THE PURPOSE OF IDENTIFYING THE LOCATION OF A WATER RIGHT ONLY AND IS NOT INTENDED TO PROVIDE LEGAL DIMENSIONS OR LOCATION OF PROPERTY OWNERSHIP LINES.

