


Township 6 South, Range 1 West, W.M.

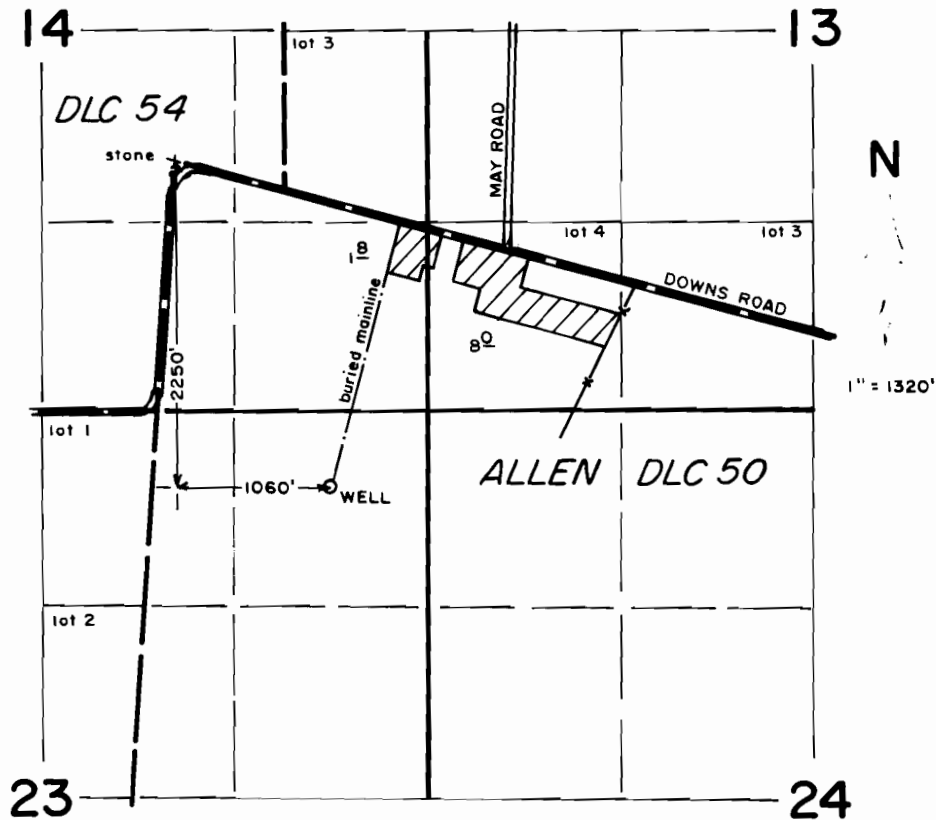

FINAL PROOF SURVEY

under

Appl. No. G-13377, Per. No. G-11850

in name of

PAUL KRAEMER

Nov. 19, 1997



ED
RESOURCES TO
THIS MAP WAS PREPARED FOR THE PURPOSE OF IDENTIFYING THE LOCATION OF A WATER RIGHT ONLY AND IS NOT INTENDED TO PROVIDE LEGAL DIMENSIONS OR LOCATION OF PROPERTY OWNERSHIP LINES.