


T.5S. R.2.W, W.M

RECEIVED

SEP 03 1998

WATER RESOURCES DEPT.
SALEM, OREGON

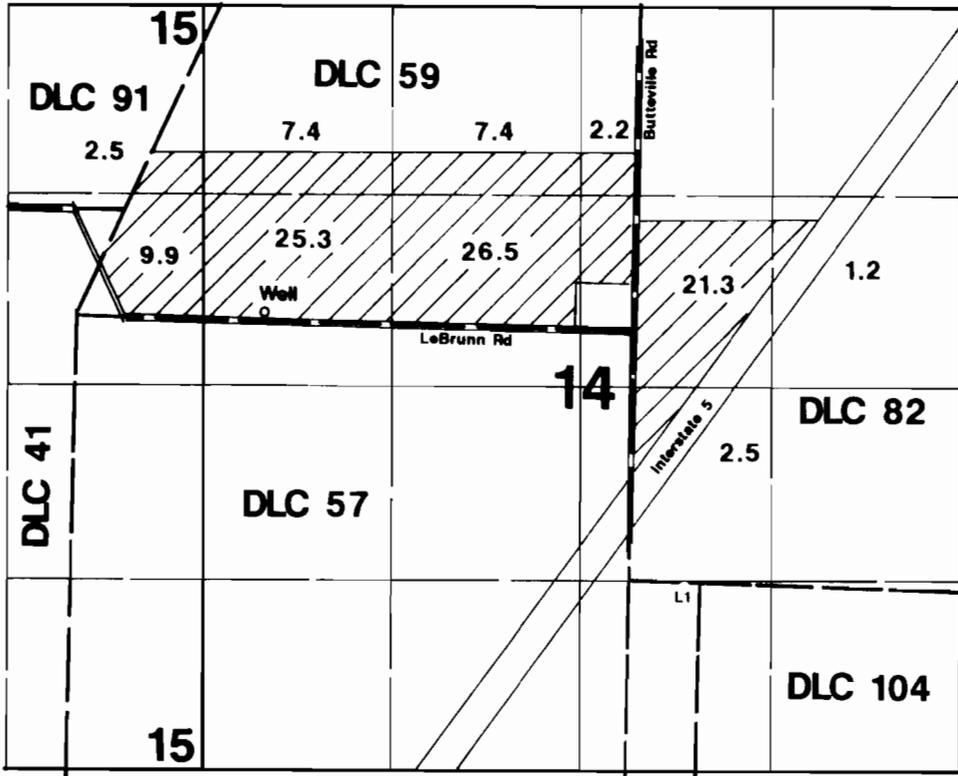

1" = 1320'



Well is located 480'N & 2550'W from the center of Section 14.

Final Proof Survey

Application #: G-13404 Permit #: G-11852

In Name Of

John Weisz Jr.

Surveyed on August 18, 1998 by JM Schuette

This Map Was Prepared For The Purpose Of Identifying The Location Of A Water Right Only And Is Not Intended To Provide Legal Dimensions Or Location Of Property Ownership Lines.

