


T.4S. R.2W & 3W., W.M

RECEIVED

SEP 14 1998

WATER RESOURCES DEPT
SALEM, OREGON

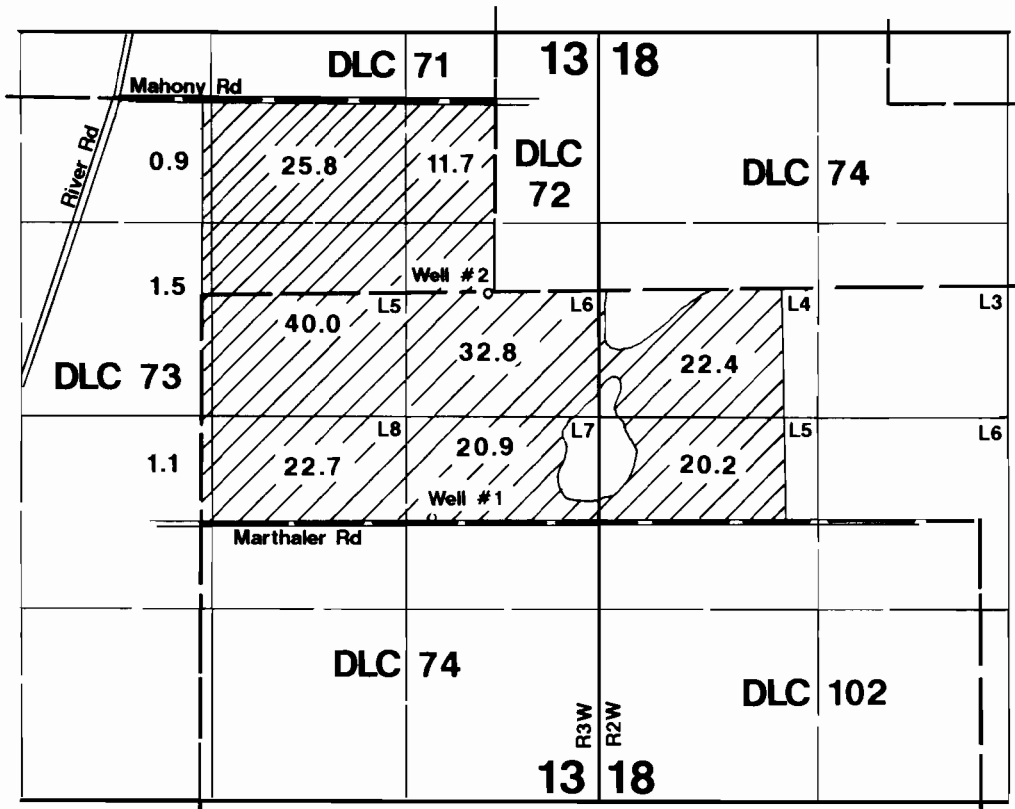

Well # 1 is located 40'N & 1600'E from the NW corner of DLC 74.
Well # 2 is located 15'S & 25'W from the SW corner of DLC 72.

Final Proof Survey

Application #: G-13412 Permit #: G-11857

In Name Of

Roselawn Seed, Inc.

Surveyed on August 18, 1998 by JM Schuette

This Map Was Prepared For The Purpose Of Identifying The Location Of A Water Right Only And Is Not Intended To Provide Legal Dimensions Or Location Of Property Ownership Lines.

