


T.5S. R.1W., W.M

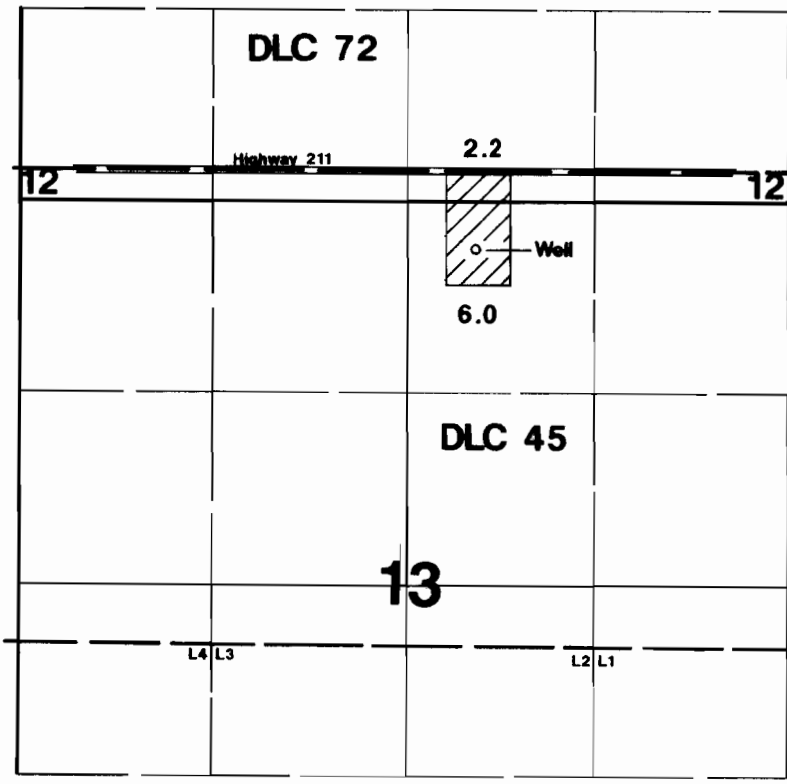

1" = 1320'



Area Irrigated

Well is located 330'S & 2170'W from the NE corner of Section 13.

Final Proof Survey

RECEIVED

SEP 30 1998

Application #: G-13490 Permit #: G-11864

In Name Of

B-West Hills Nursery

Surveyed on September 22, 1998 by JM Schuette

WATER RESOURCES DEPT
SALEM, OREGON

This Map Was Prepared For The Purpose Of Identifying The Location Of A Water Right Only And Is Not Intended To Provide Legal Dimensions Or Location Of Property Ownership Lines.

