



T. 7 S., R. 2 W., W.M.

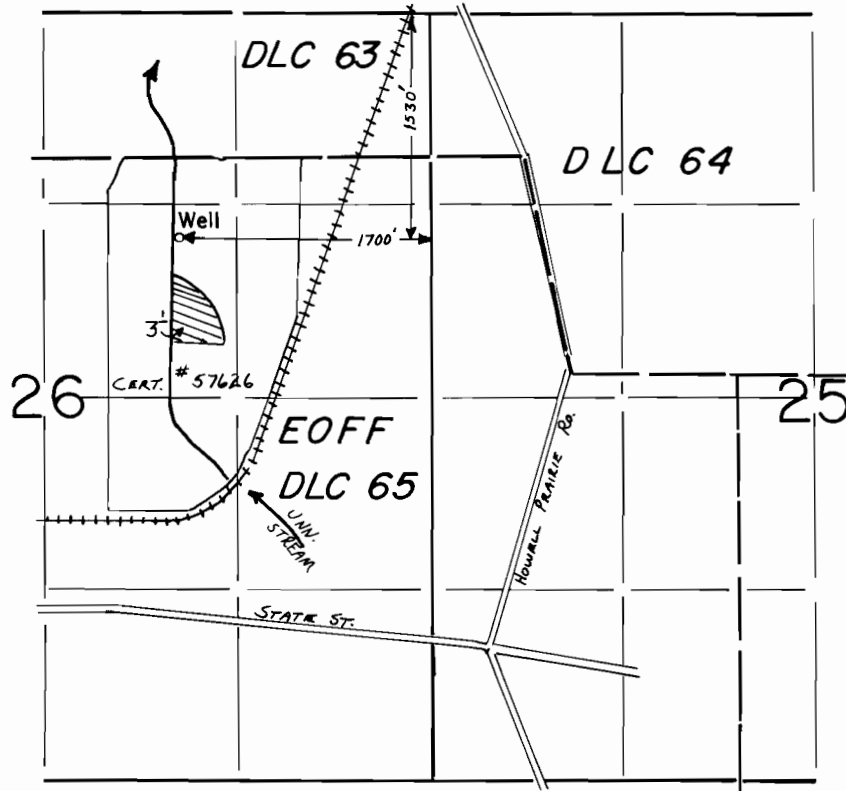

THIS MAP WAS PREPARED SOLELY FOR THE PURPOSE OF DelineATING THE LOCATION OF A WATER RIGHT, AND HAS NO INTENT OF BEING USED TO DETERMINE ANY PROPERTY BOUNDARIES.

Scale: 1" = 1320'

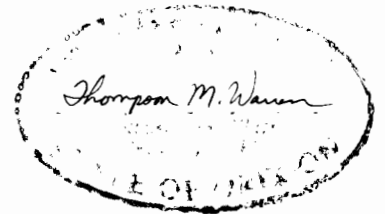

### FINAL PROOF SURVEY

Application No. G-13528 Permit No. G-11868

in name of

GARY L. KAUFMAN

Surveyed June 14, 1996

RECEIVED

JUN 15 1996

WATER RESOURCES DIVISION  
STATE OF OREGON

ASCS  
PHOTO  
DFN-6LL-210