
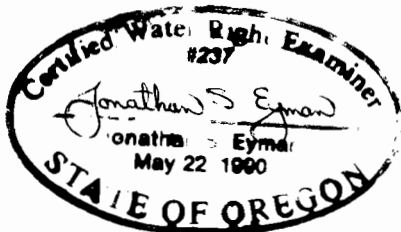


Section 3, T.4S, R.1E., W.M.

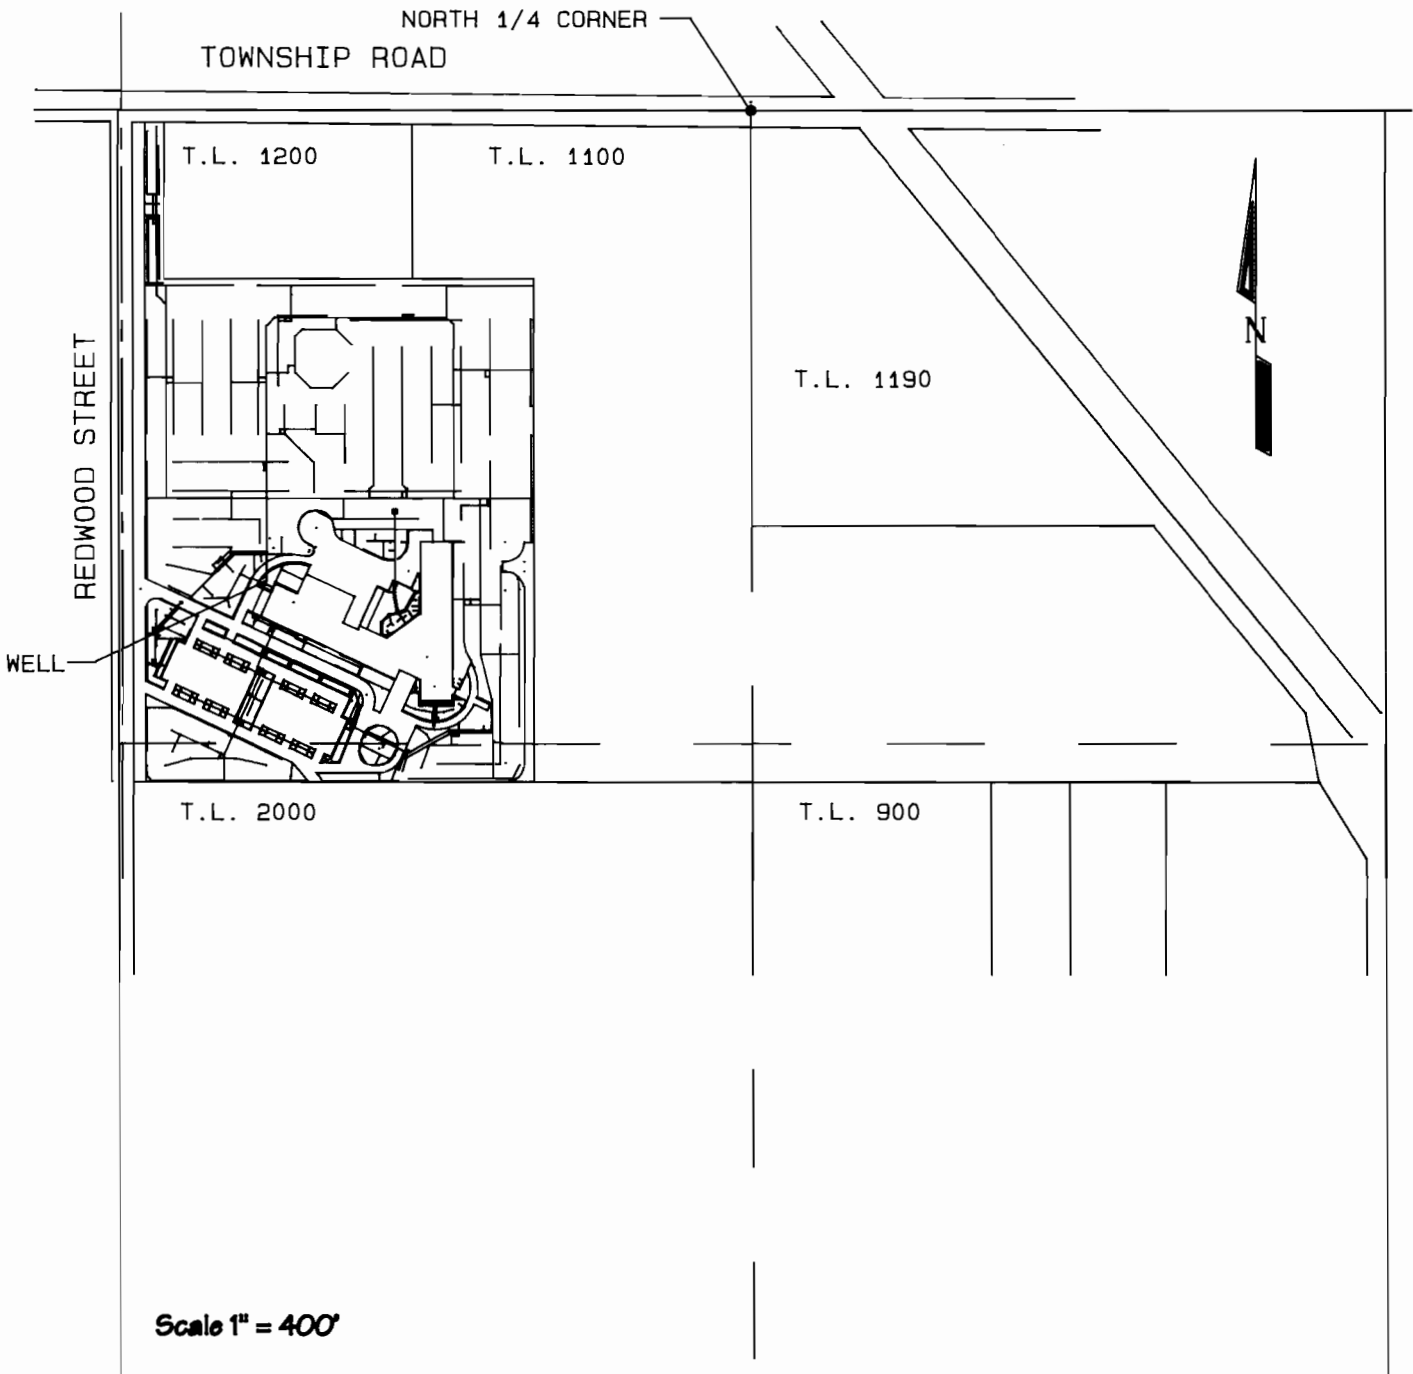

BENEFICIAL USE MAP
FOR
CANBY ELEMENTARY SCHOOL DISTRICT
APPLIC. NO. 6-13199 PERMIT NO. G11874

THE PREPARATION OF THIS MAP IS FOR THE PURPOSE OF IDENTIFYING THE LOCATION OF THE WATER RIGHT ONLY AND HAS NO INTENT TO PROVIDE DIMENSIONS OR LOCATION OF PROPERTY OWNERSHIP LINES.