


T. 5 S., R. 2 W., W. M.
Section 2

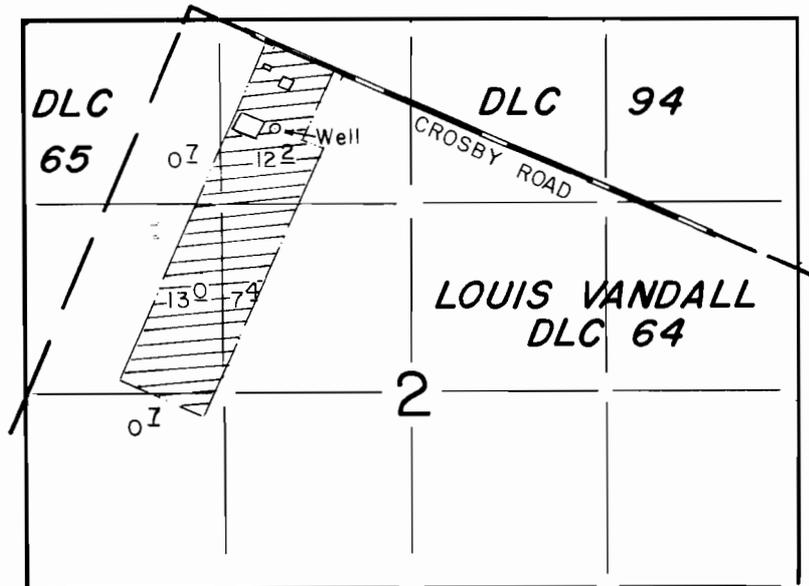

Scale: 1" = 1320'



Well Loc.: 840' S. & 550' E. from NW Cor. DLC 64

FINAL PROOF SURVEY
UNDER

A # G-11235

P#G-11875

IN NAME OF

Dr. CLEON L. & BENNE B. MILLER

SURVEYED AUG. 24, 1995 by T. M. Warren

THIS MAP WAS PREPARED SOLELY FOR THE PURPOSE OF DEPICTING THE LOCATION OF A WATER RIGHT, AND HAS NO INTENTION OF BEING USED TO DETERMINE REAL PROPERTY BOUNDARIES.

