


T.4S. R.1E., W.M

RECEIVED

SEP 25 1998

WATER RESOURCES DEPT
SALEM, OREGON

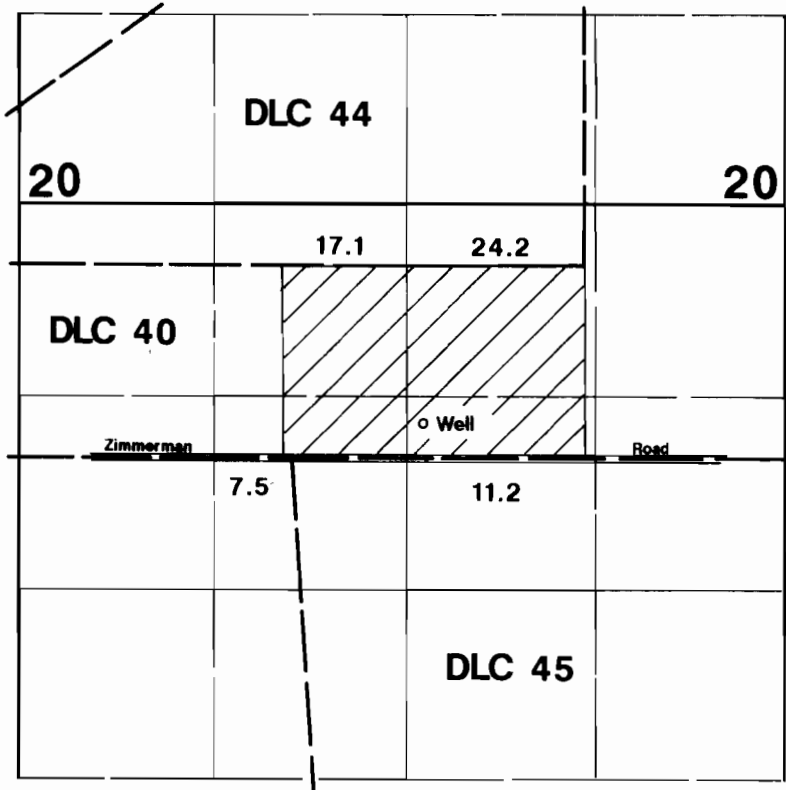

1" = 1320'



Well is located 1120'S & 1102'W from the SE corner of DLC 44.

Final Proof Survey

Application #: G-13284 Permit #: G-11878

In Name Of

Pure Seed Testing Inc.

Surveyed on September 18, 1998 by JM Schuette

This Map Was Prepared For The Purpose Of Identifying The Location Of A Water Right Only And Is Not Intended To Provide Legal Dimensions Or Location Of Property Ownership Lines.

