

RECEIVED

SEP 28 1998


WATER RESOURCES DEPT
SALEM, OREGON

FINAL PROOF SURVEY

FOR JACK SPARROWK
PERMIT G-11880
LOCATED IN SECTIONS 16, 17, 20 AND 21
TOWNSHIP 38 SOUTH, RANGE 17 EAST, W.M.
LAKE COUNTY, OREGON

LEGEND

- SECTION LINES
- - - 1/4 SECTION LINES
- - - - 1/16 SECTION LINES
- ~ EXISTING DITCHES AND FLOW DIRECTION.
- FOUND 1938 GENERAL LAND OFFICE BRASS CAP ON AN IRON PIPE.
- EXISTING WELL, LOCATION AS NOTED.

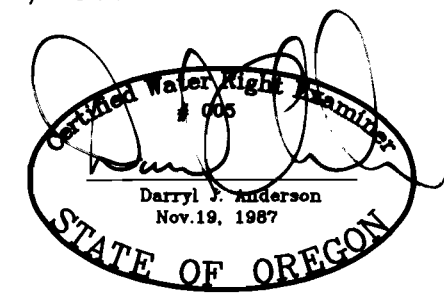

SCALE: 1"=1320'

CROSS HATCH LEGEND

- 260.20 ACRES TO BE IRRIGATED SUPPLEMENTALLY FROM WELL #1, PRIMARY WATER RIGHTS UNDER CERTIFICATE #5178, GOOSE LAKE DECREE.
- DENOTES SUPPLEMENTAL IRRIGATION ACREAGES.
- 51.12 ACRES PRIMARY WATER RIGHTS FROM WELL #1.
- DENOTES PRIMARY IRRIGATION ACREAGES.

NOTES

- 1) ALL LANDS SHOWN AS BEING EITHER PRIMARY OR SUPPLEMENTAL IRRIGATION ARE BEING FLOOD IRRIGATED.
- 2) PREPARATION OF THIS MAP IS FOR IDENTIFYING PROPOSED WATER RIGHTS ONLY. IT HAS NO INTENT TO PROVIDE LOCATIONS OR DIMENSIONS OF PROPERTY BOUNDARIES.

REVISION	BY

ANDERSON ENGINEERING AND SURVEYING, INC.
P.O. BOX 28
LAKEVIEW, OREGON 97630
(541) 947-4407
FAX 947-2321

P.O. BOX 419
REDMOND, OREGON 97756
(541) 923-4307
FAX 923-4308

PREPARED FOR: **JACK SPARROWK**
P.O. BOX 657
CLEMETS, CA 95227

DATE: 8/19/98
SCALE: 1"=1320'
JOB: 98032
DWG. BY: R.F.C.
FILE: 98032
SHEET 1 OF 1