


T.9 S. R.1 W. W.M.

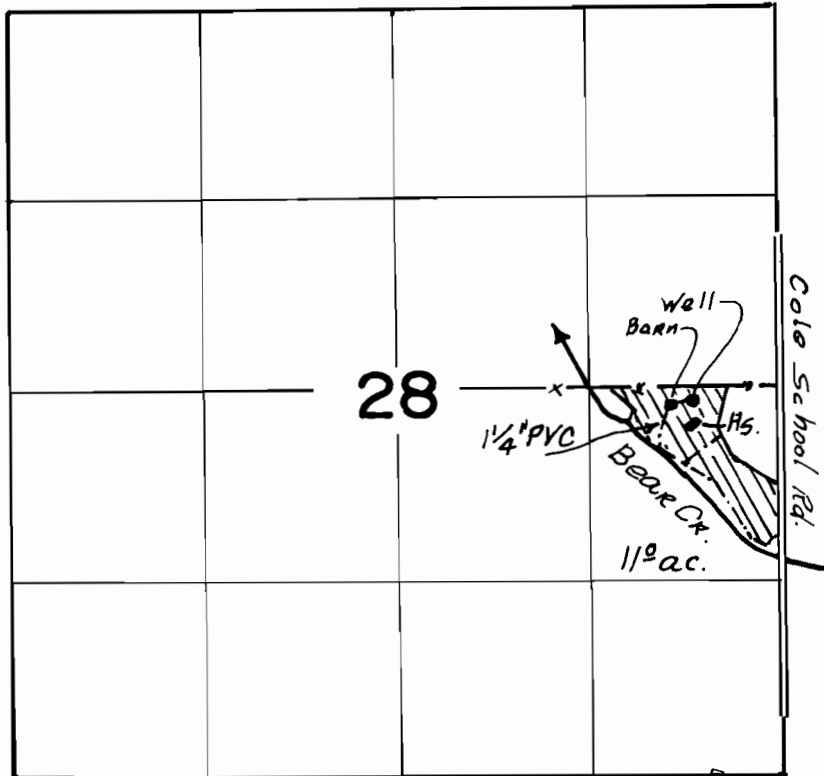

Well Loc: 100' S & 380' W From E 1/4 COR. Sec. 28


FINAL PROOF SURVEY UNDER

Application No. G-13651. Permit No. G-11890.

IN NAME OF

JUDD SAWYER

Surveyed April 24, 2001, by

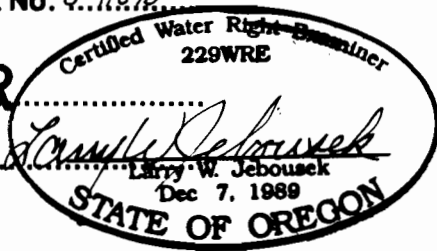

THIS MAP WAS PREPARED FOR THE PURPOSE OF IDENTIFYING THE LOCATION OF A WATER RIGHT ONLY AND IS NOT INTENDED TO PROVIDE LEGAL DIMENSIONS OR LOCATION OF PROPERTY OWNERSHIP LINES.