


T.8S., R.1W. & 2W., W.M

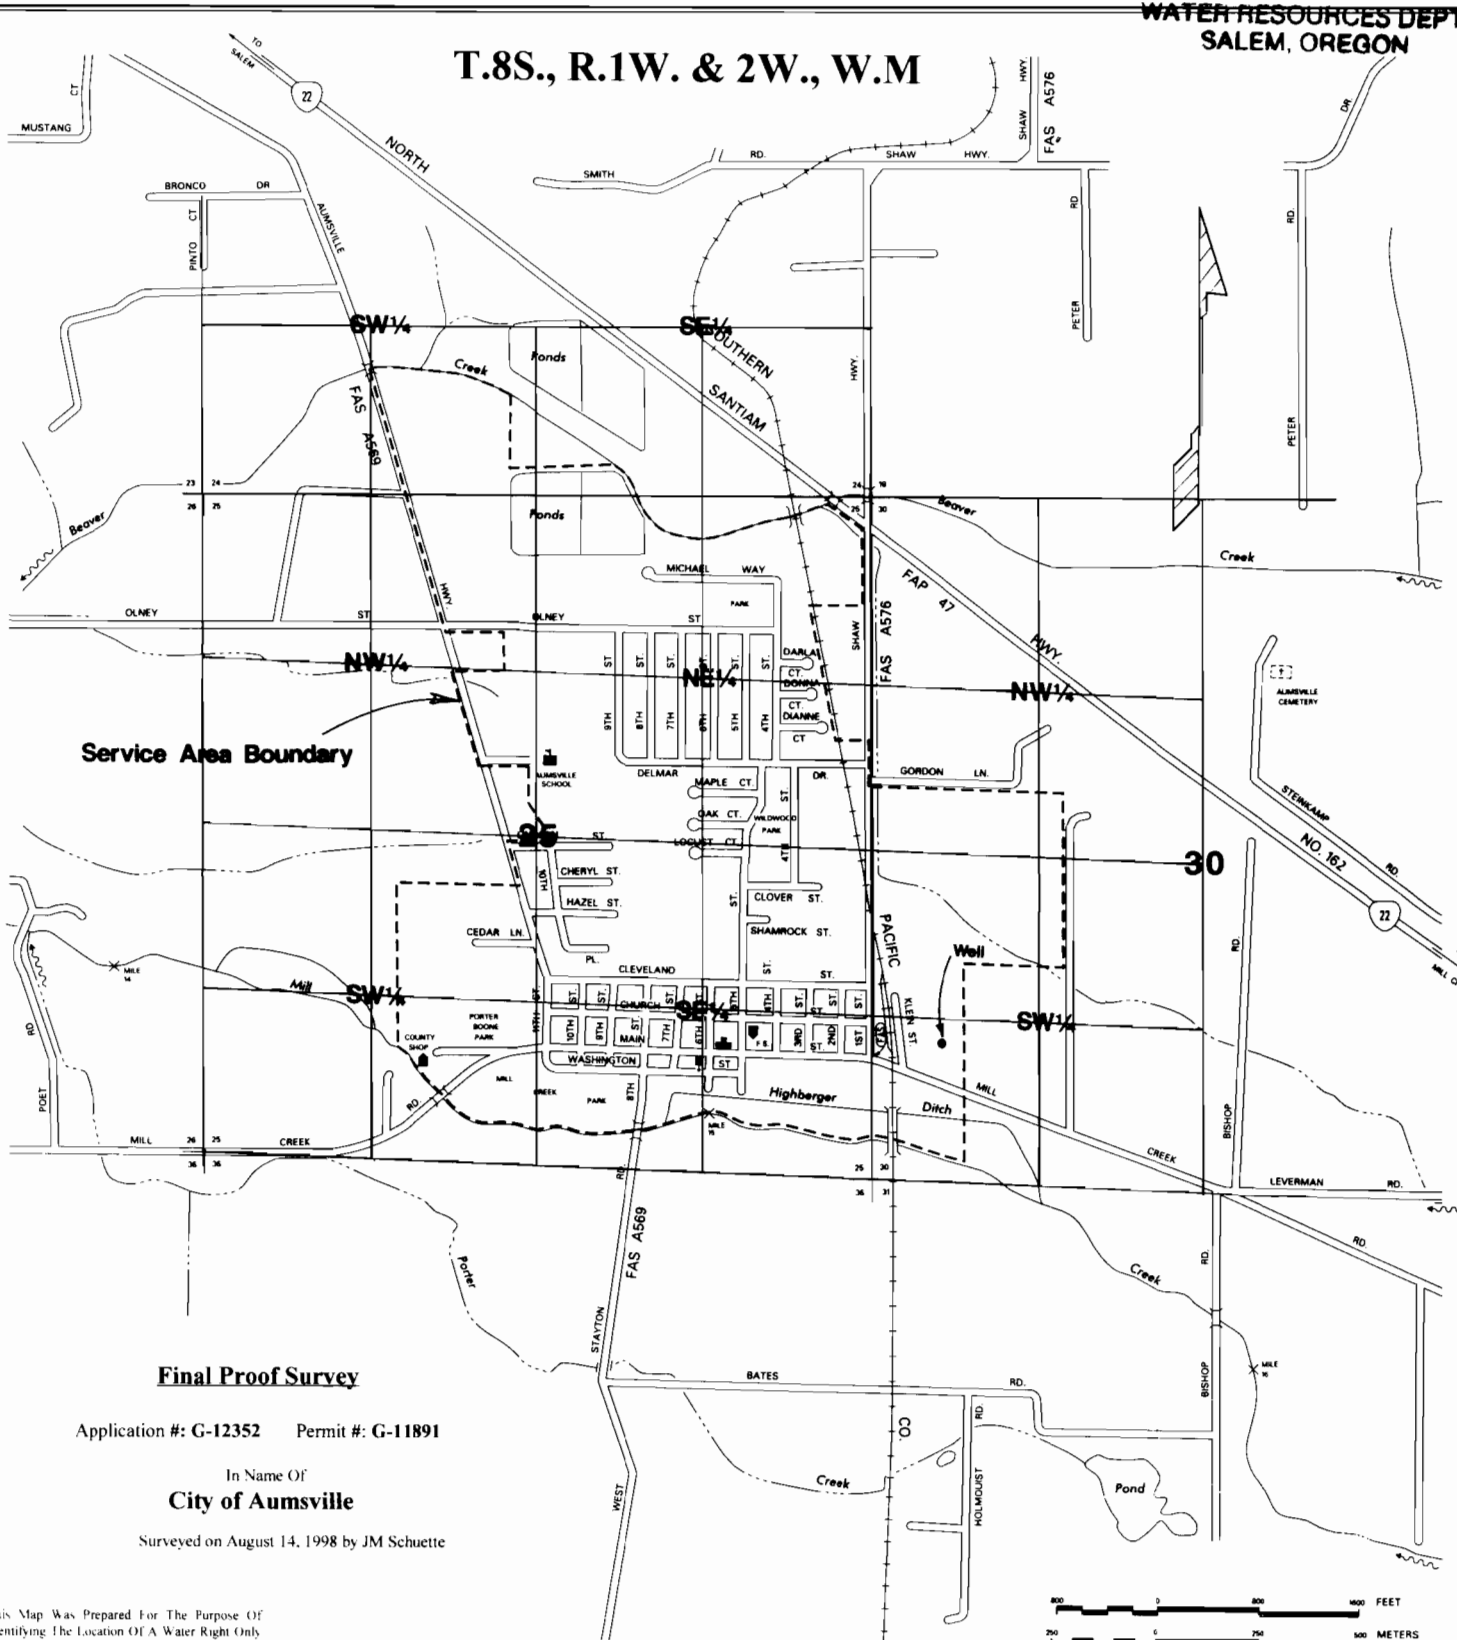

Service Area Boundary

**Final Proof Survey**

Application #: G-12352    Permit #: G-11891

In Name Of  
**City of Aumsville**

Surveyed on August 14, 1998 by JM Schuette

This Map Was Prepared For The Purpose Of  
Identifying The Location Of A Water Right Only  
And Is Not Intended To Provide Legal Dimensions  
Of Location Of Property Ownership Lines

Well is located 1100'N & 550'E from SW corner Section 30.



Scale

