


T.5S., R.1W., W.M

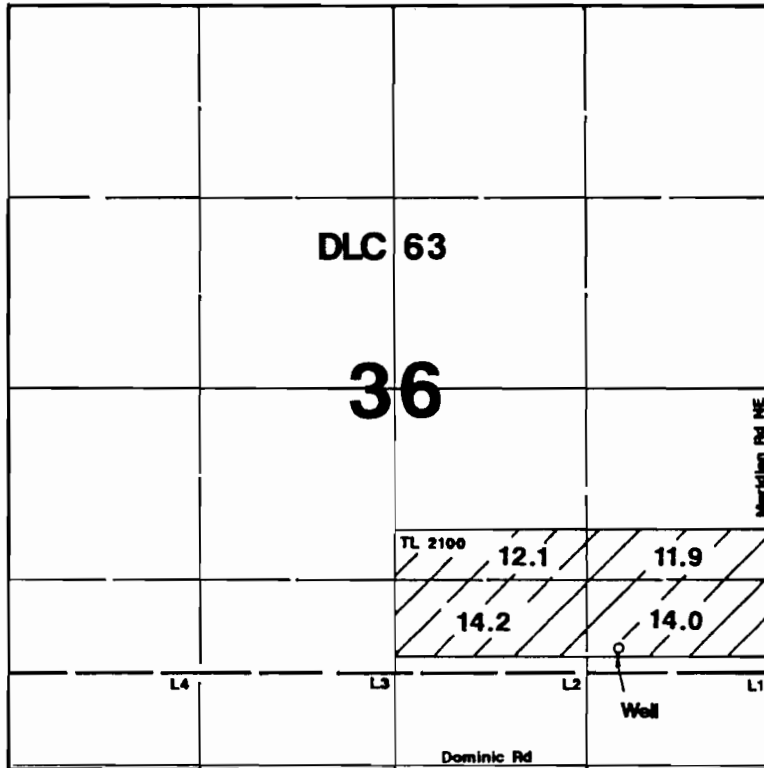

Well is located 886'N & 1034'W from the SE corner of Section 36.

Final Proof Survey

Application: G-12547 Permit #: G-11894

In Name Of

James Butsch

Surveyed on June 18, 2001 by JM Schuette

This Map Was Prepared For The Purpose Of Identifying The Location Of A Water Right Only And Is Not Intended To Provide Legal Dimensions Or Location Of Property Ownership Lines.

