


T. 6 S. R. 1 W. W.M.

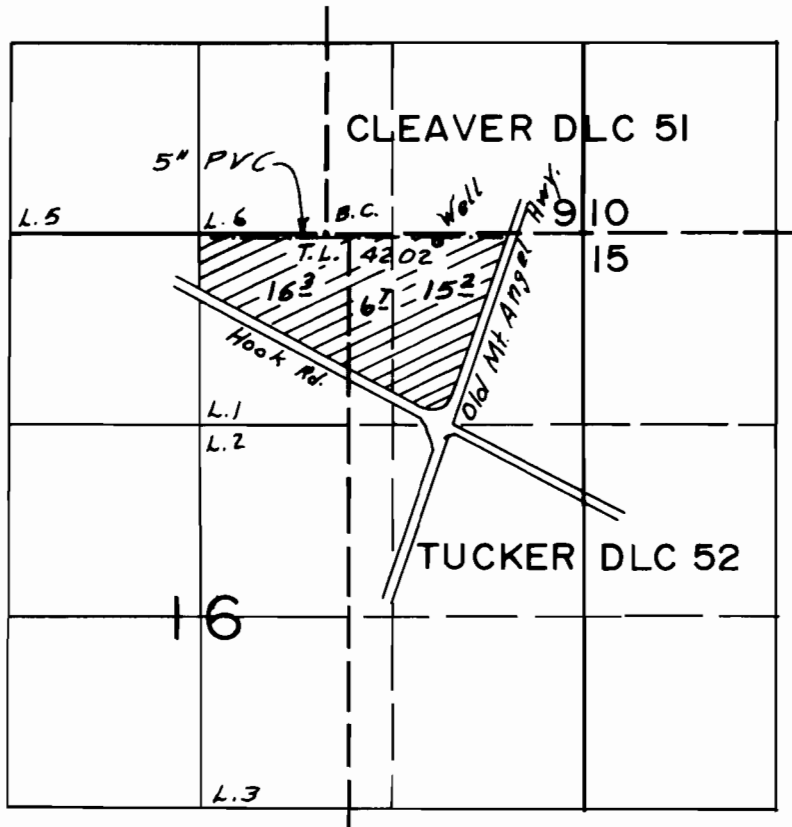

Well: 55' S & 770' E from SW cor. DLC 51


FINAL PROOF SURVEY FOR

APPL. NO. G-13304 PER. NO. G-11912

BY

SEIFER BROS.

THIS MAP WAS PREPARED FOR THE PURPOSE OF IDENTIFYING THE LOCATION OF A WATER RIGHT ONLY AND IS NOT INTENDED TO PROVIDE LEGAL DIMENSIONS OR LOCATION OF PROPERTY OWNERSHIP LINES.

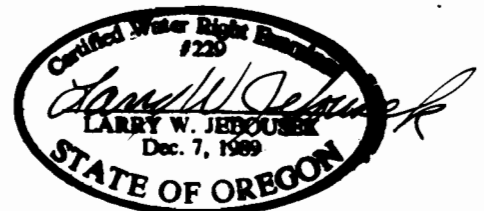

WAC Photo '92 7C-4 Survey 7-24-96