


T. 4 S., R 4 E., W. M.

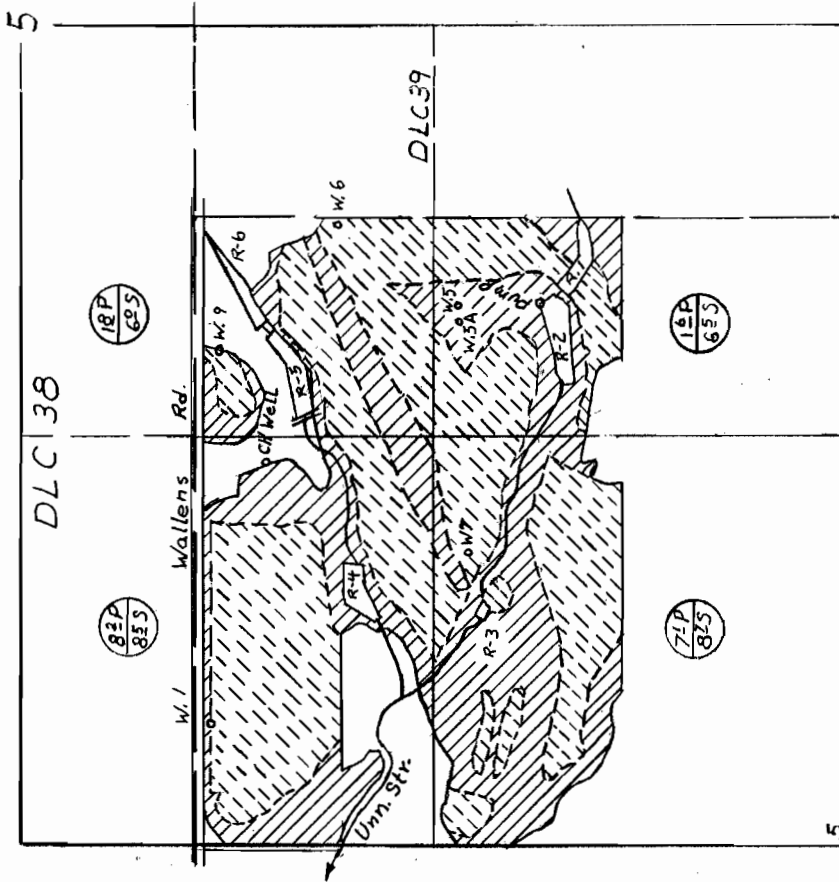

Water Right Map For  
Springwater Golf Course



Scale  
1" = 400'

All div. pts located from N.W. cor. DLC 39

Reservoirs	Wells
R-1 1190' S 230' W	W. 1 100' S 1550' W
R-2 1180' S 530' W	W. 5 840' S 280' W
R-3 920' S 1380' W	W. 5A 850' S 330' W
R-4 580' S 1390' W	W. 6 460' S 30' W
R-5 350' S 640' W	W. 7 880' S 1070' W
R-6 220' S 350' W	C.H. 230' S 780' W
	W. 9 80' S 430' W

THIS MAP WAS PREPARED FOR THE PURPOSE OF IDENTIFYING THE LOCATION OF A WATER RIGHT ONLY AND IS NOT INTENDED TO PROVIDE LEGAL DIMENSIONS OR LOCATION OF PROPERTY OWNERSHIP LINES.

APPROVED  
DEC 27 1989  
STATE ENGINEER  
LARRY W. JOHNSON

Primary Supplemental

Application No. R-73359  
Permit No. R11508