

**NOTE:**

THIS MAP IS FOR THE PURPOSE OF IDENTIFYING THE LOCATION OF THE WATER RIGHT ONLY AND IS NOT INTENDED TO PROVIDE LEGAL DIMENSIONS OR LOCATION OF PROPERTY OWNERSHIP LINES.

**SEC. 4, T.5S, R.1W, W.M.**

**RECEIVED**

SEP 03 1996

WATER RESOURCES DEPT.  
SALEM, OREGON

GOUDY GARDENS

APPLICATION NO. 12286  
PERMIT NO. G-11449

FD. 3/4" I.P.

13

12

11

10

S.W. CORNER  
PURVINE D.L.C. NO. 60

3819'

827'

CARL RD. (CO. RD. NO. 531)

S.E. 1/4  
S.W. 1/4  
8.15 Ac.

WELL  
LOCATION

S.W. 1/4  
S.E. 1/4  
2.0 Ac.

3" LATERALS AT  
60' C/C (TYPICAL)

6" SURFACE  
HEADER

SOUTH  
1/4 CORNER

3" LATERALS AT  
60' C/C (TYPICAL)


SECTION 4  
SECTION 9

**FINAL PROOF SURVEY  
FOR  
DOUGLAS BERNING**



SCALE - 1" = 400'

APPLICATION NO. G-13310  
PERMIT NO. G-11924

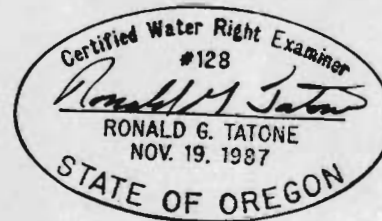

AUG. 12, 1996

**ZTec ENGINEERS, INC.**

3737 S.E. 8TH AVE., PORTLAND, OR. 97202  
PHONE: (503) 235-8795  
FAX: (503) 233-7889