


TIIS. R5W. W.M.

RECEIVED


MAY 1 1996

WATER RESOURCES DEPT
SALEM OREGON

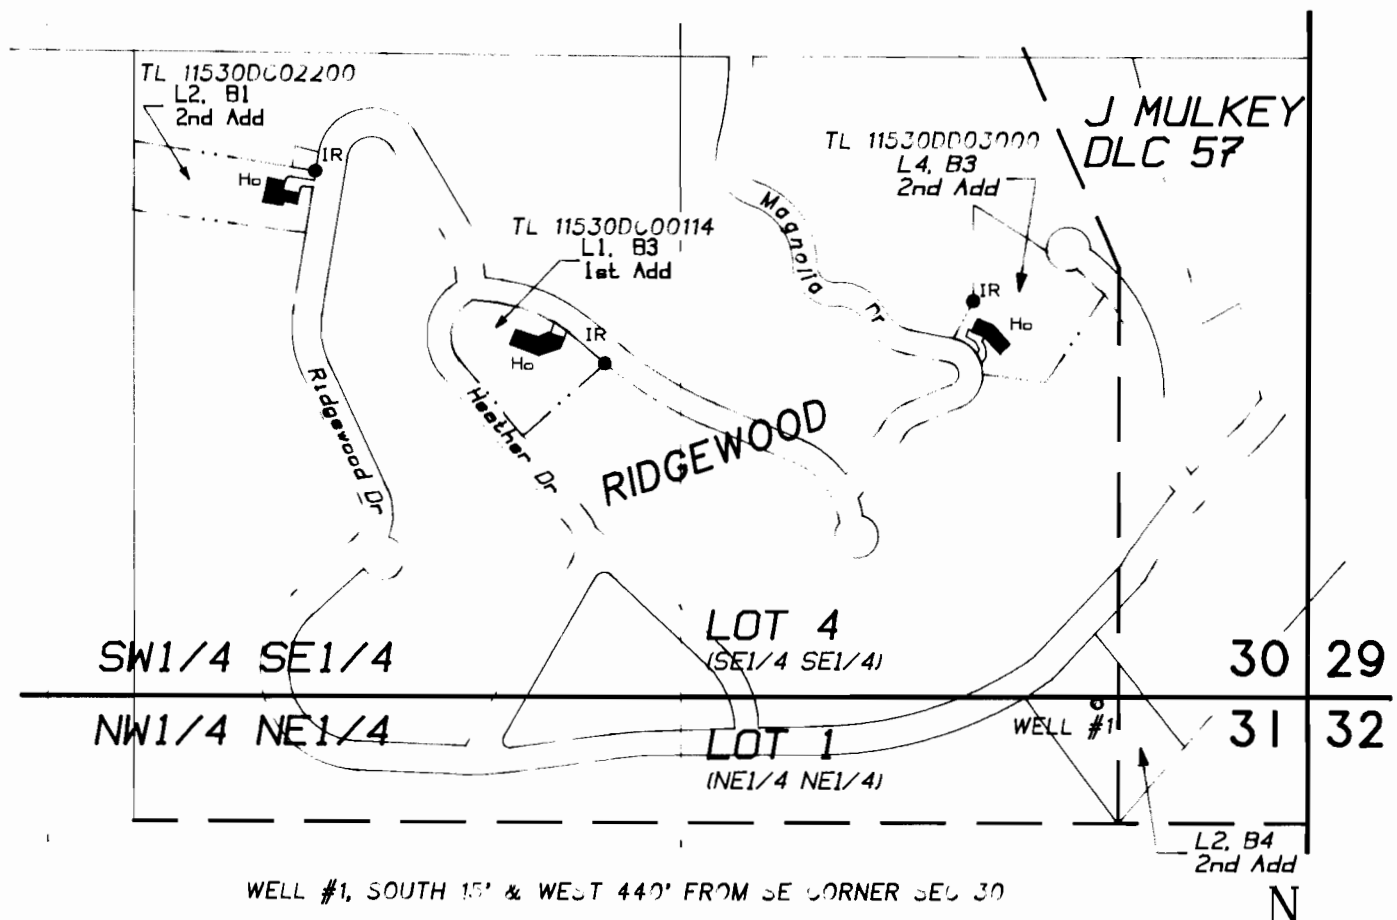

FINAL PROOF SURVEY
 UNDER
 Application No. G-12753 Permit No. G-11930
 IN THE NAME OF
RIDGEWOOD DISTRICT IMPROVEMENT CO.

Surveyed FEB 19, 1996
 PARSONS SURVEYING
 1915 SE Stone Street
 Corvallis, OR 97333
 (503) 752-7515
 PROJECT #9530

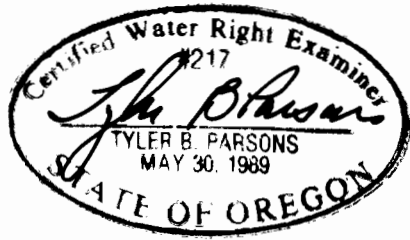

NOTE: Map is for purpose of identifying location of water right and does not dimension or locate property ownership lines.

EXP: 12/31/96

1" = 400'