


T.8S. R.2W., W.M

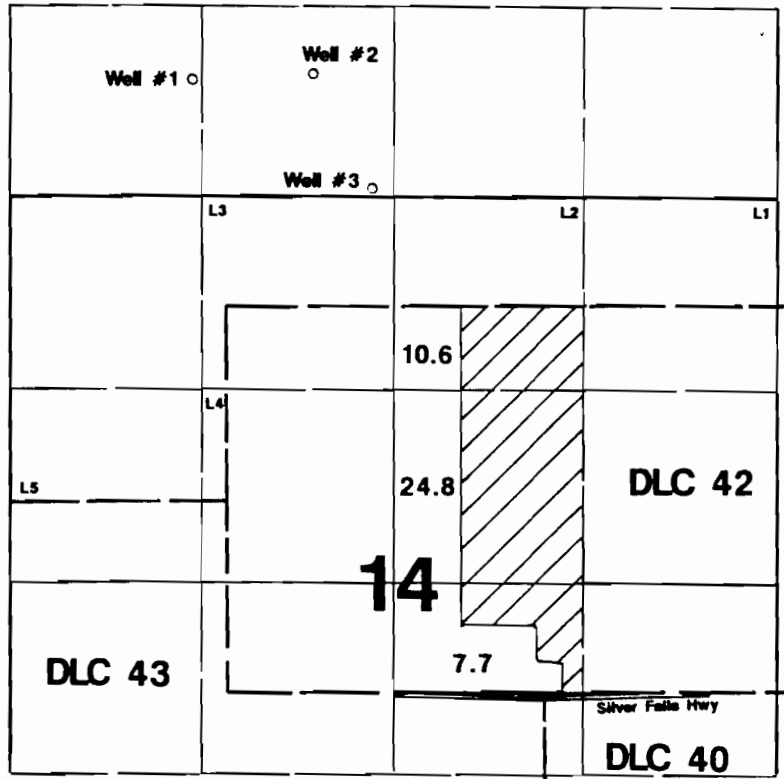

Well #1 is located 1800'S & 1850'W
Well #2 is located 1750'S & 950'W ---all from the SW corner of DLC 41.
Well #3 is located 2550'S & 520'W

Final Proof Survey

Application #: G-13204 Permit #: G-11934

In Name Of

Charles D. Wavra

Surveyed on June 30, 1999 by JM Schuette

This Map Was Prepared For The Purpose Of Identifying The Location Of A Water Right Only And Is Not Intended To Provide Legal Dimensions Or Location Of Property Ownership Lines.

