


# CLAIM OF BENEFICIAL USE


APPLICATION No. G-12628

PERMIT No. G-11937

TAX LOT No. 1844C 3900 - MALHEUR COUNTY

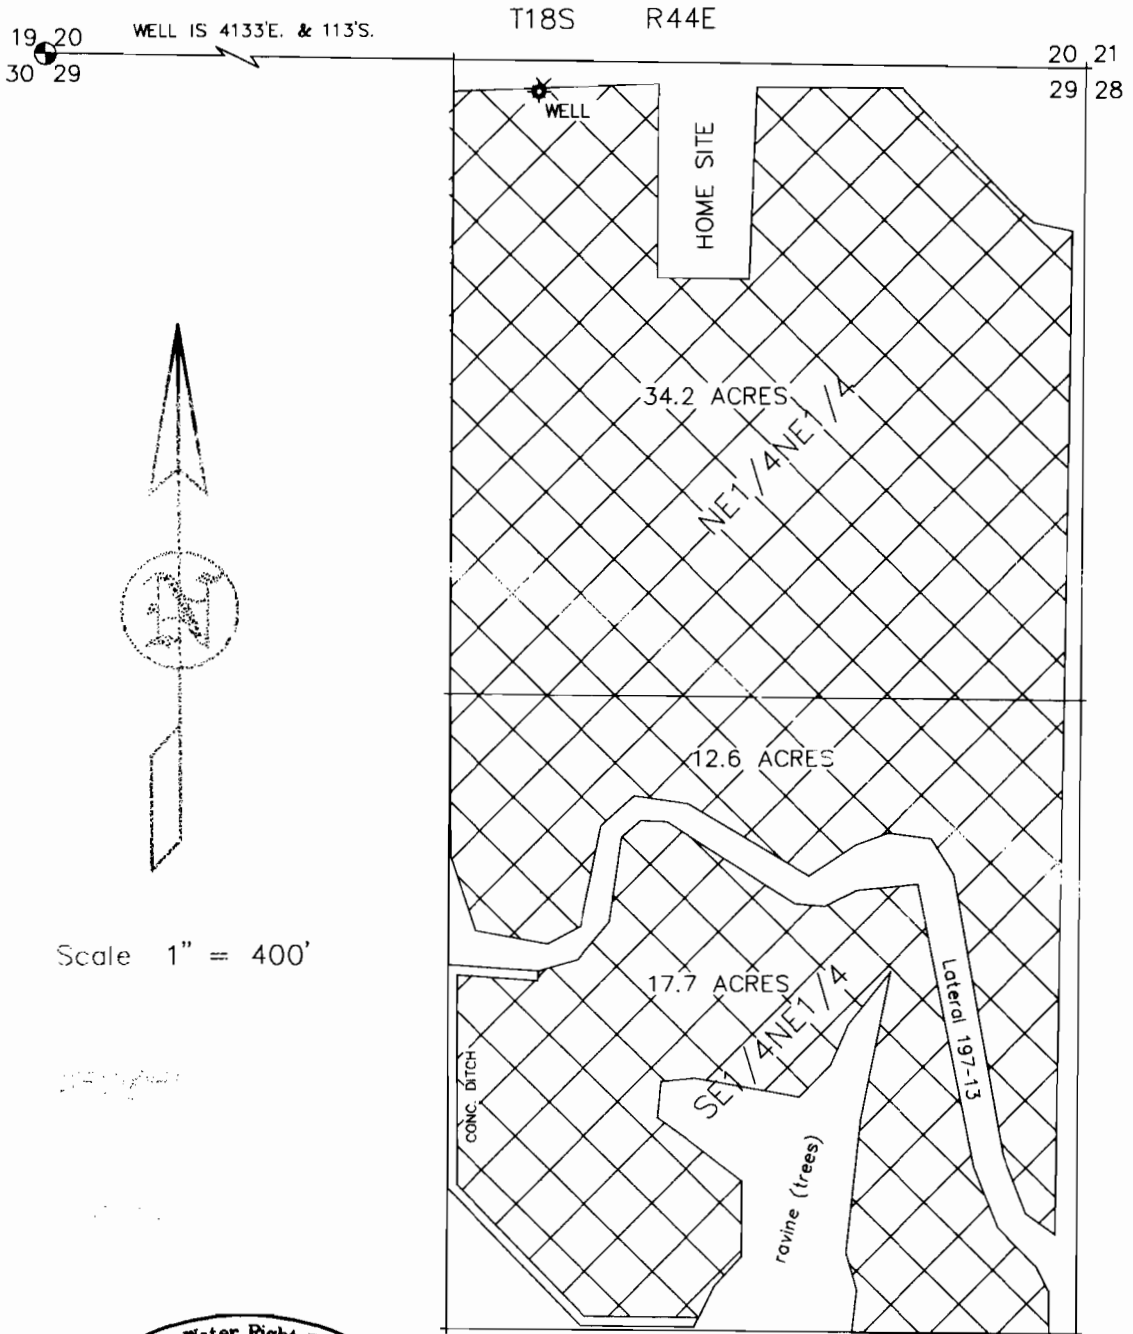

Scale 1" = 400'

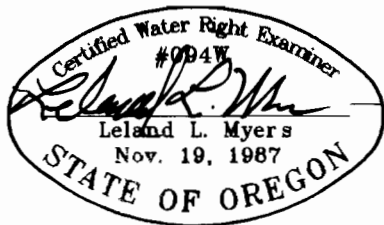

This map is for the purpose of identifying the location of the water right only and has no intent to provide dimensions or location of property ownership lines.