


Township 6 South, Range 1 West, W. M.

Portions of Sections 20, 21, 28 & 29

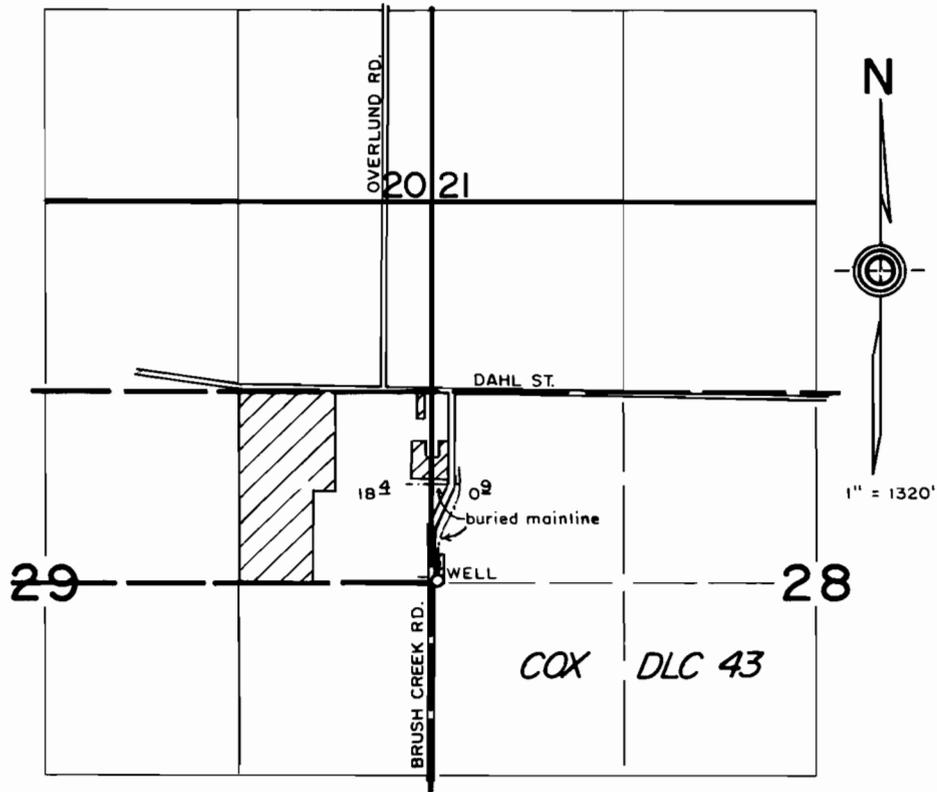

WELL LOCATED 10' N. & 35' E. FROM W. 1/4 COR. SEC. 28.

FINAL PROOF SURVEY


under

Appl. No. G-13620, Per. No. G-11946

in name of

JIM ZITZELBERGER

June 26, 1995

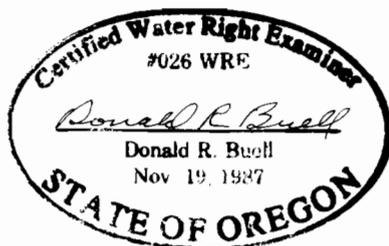

THIS MAP WAS PREPARED FOR THE PURPOSE OF IDENTIFYING THE LOCATION OF A WATER RIGHT ONLY AND IS NOT INTENDED TO PROVIDE LEGAL DIMENSIONS OR LOCATION OF PROPERTY OWNERSHIP LINES.