

# FINAL PROOF SURVEY

APPLICATION No. G-12643

PERMIT No. G-11955

Applicant: Tameno Farms  
1435 Hillcrest Drive  
Vale, OR 97918

SCALE : 1" = 400'



**RECEIVED**

T18S, R46E, WM

OCT 01 1999

S19 S20

WATER RESOURCES DEPT.  
SALEM, OREGON

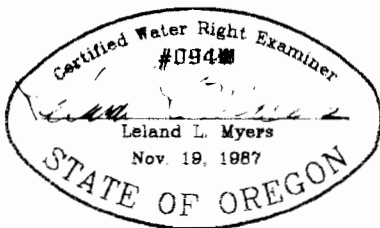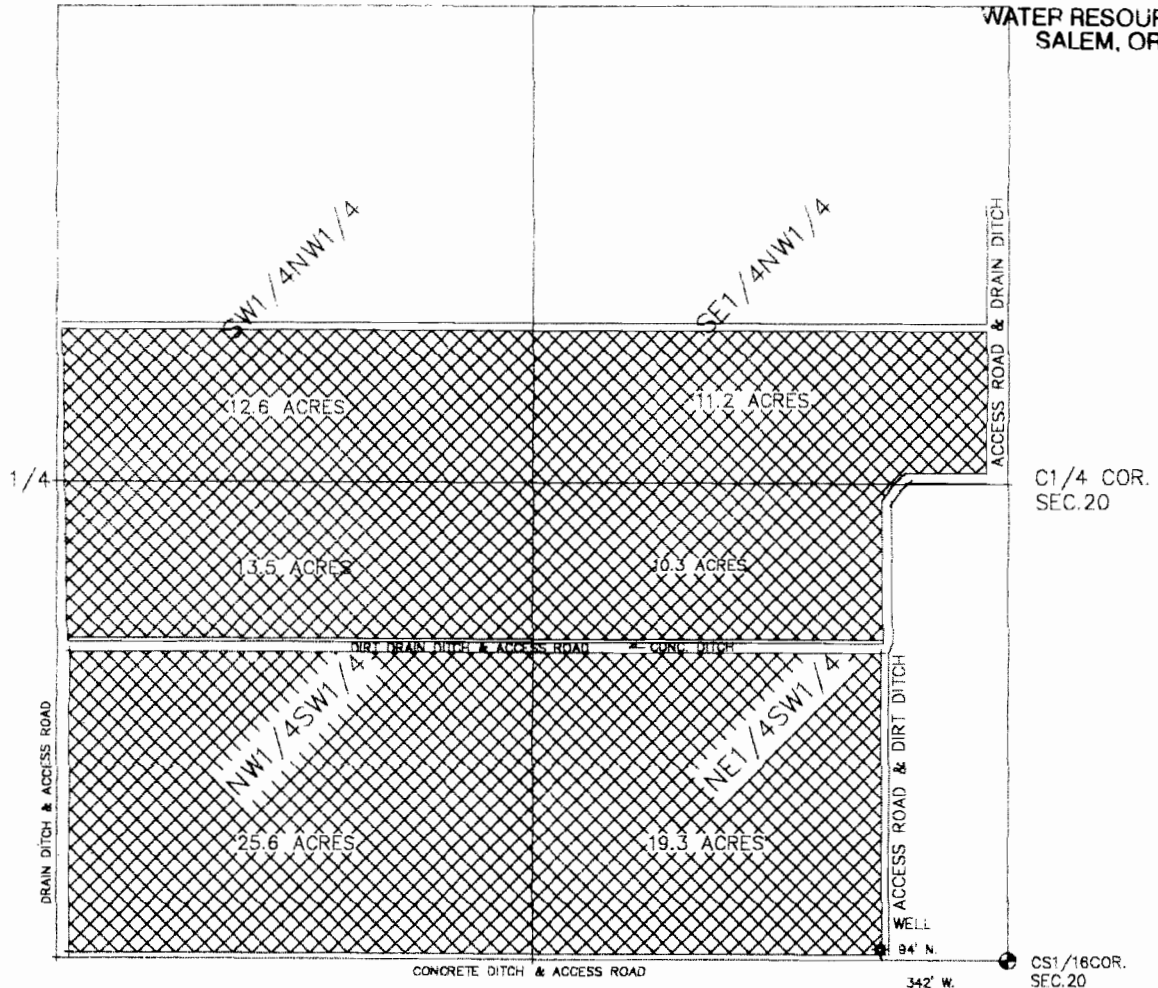

This map is for the purpose of identifying the location of the water right only and has no intent to provide dimensions or location of property ownership lines.